


T.10S.R.2W.W.M.

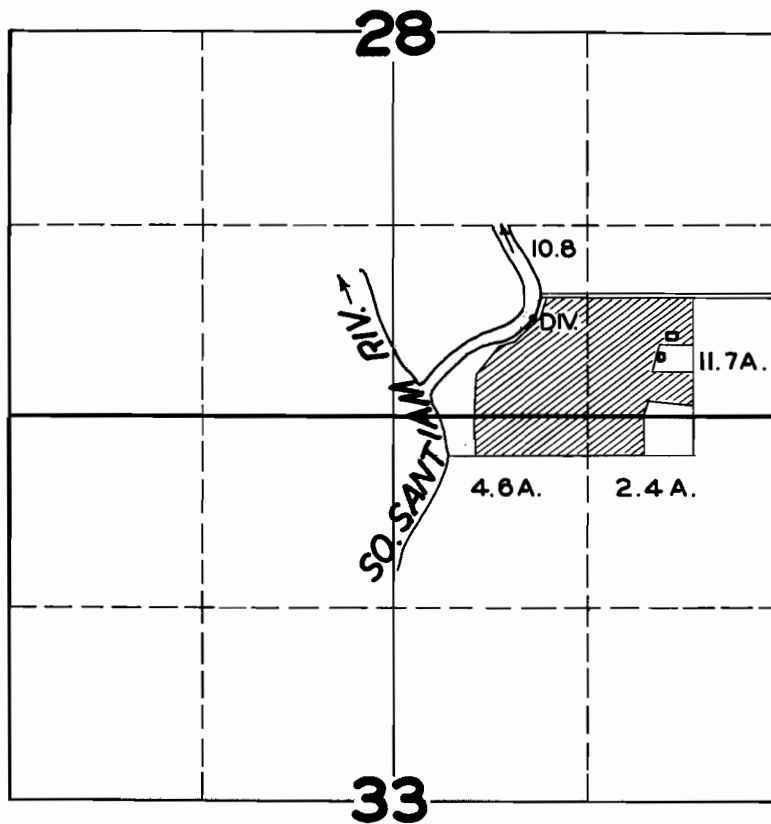

FINAL PROOF SURVEY
UNDER

Application No. **19596** Permit No. **15183**
IN NAME OF

L.C. STUCKER

Surveyed **APR. 19**, 1948, by **JAS. E. BUNNELL**