


T.8S.R.4W.W.M.

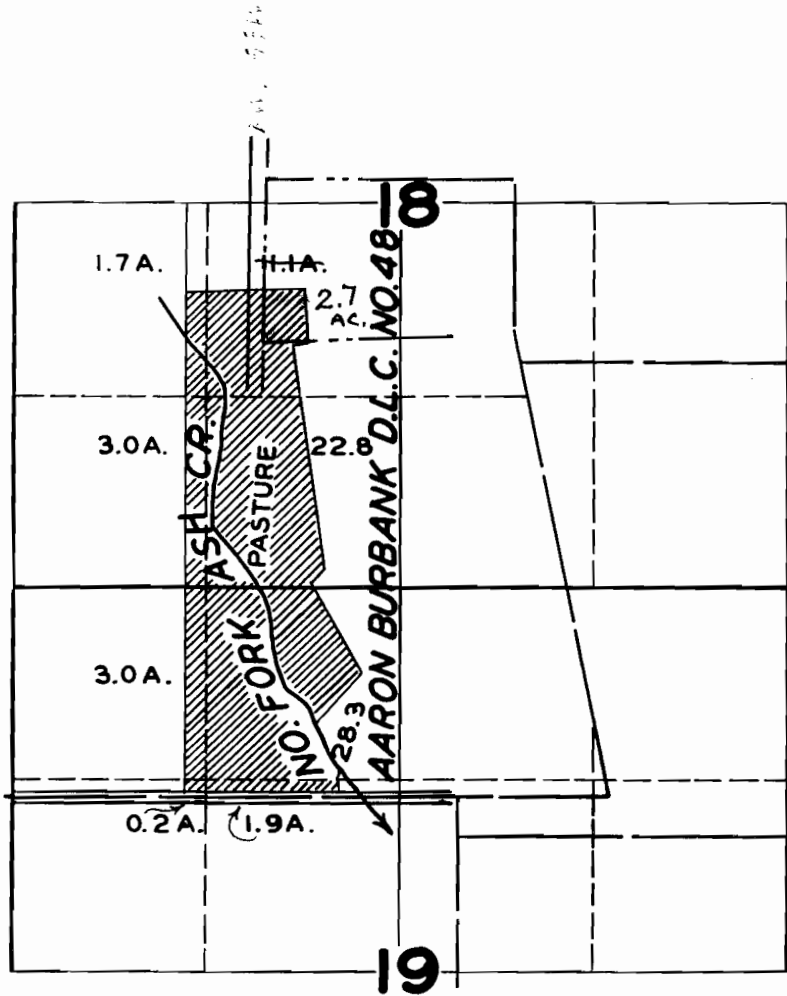

FINAL PROOF SURVEY

UNDER

Application No. **20315** ... Permit No. **15848**

IN NAME OF

J. K. RIDDELL

Surveyed **MAY 11** . 1948, by **JAS. E. BUNNELL**