


T.6S.R.8W.W.M.

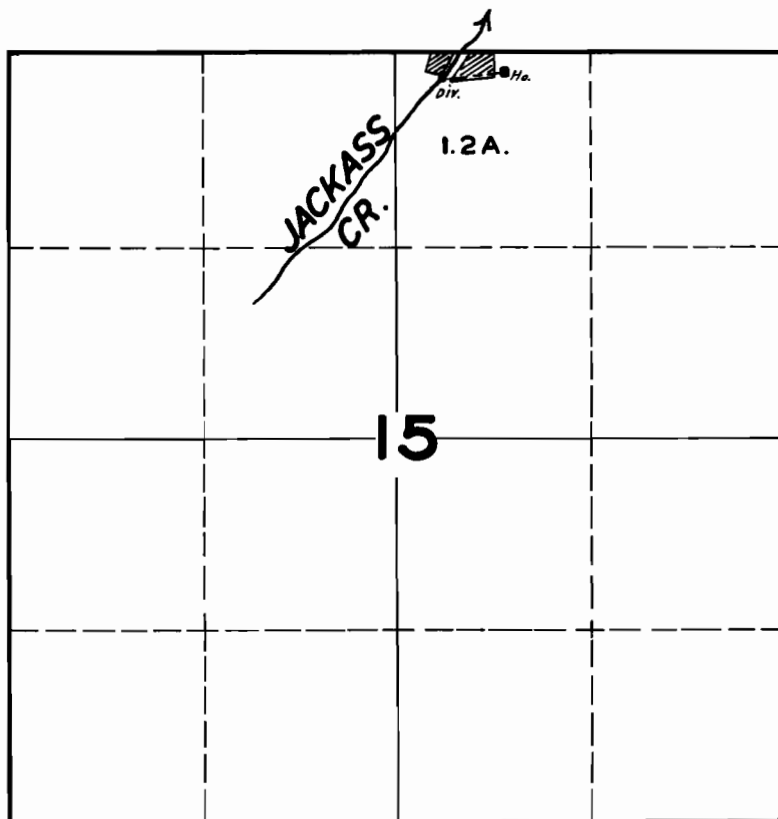

FINAL PROOF SURVEY
UNDER

Application No. **20678** Permit No. **16176**.....
IN NAME OF

CLYDE C. BICE.....

Surveyed **MAR. 15**, 1949, by **JAS. E. BUNNELL**