


T.4S.R.4W.W.M.

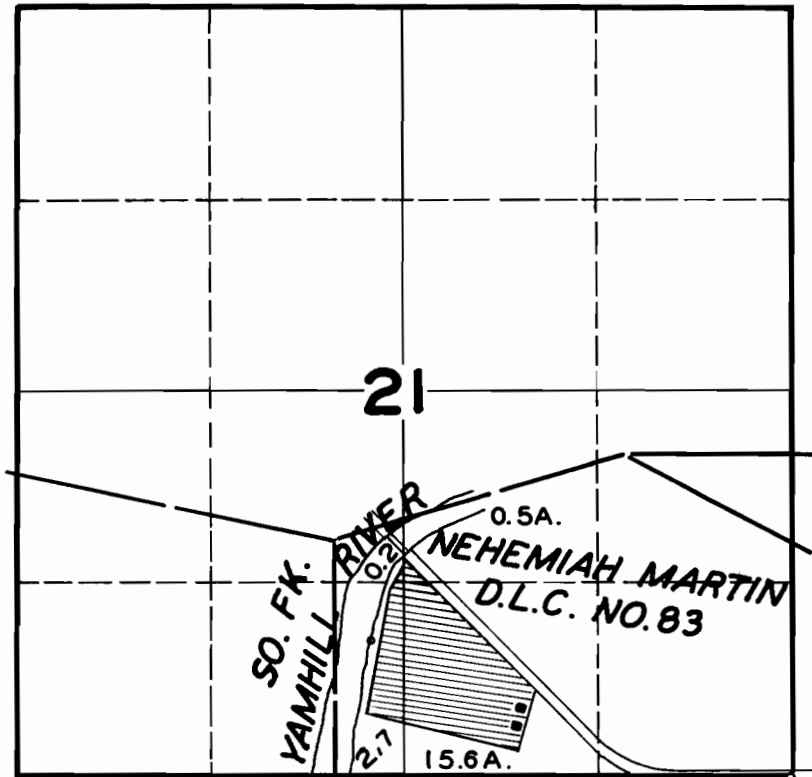

FINAL PROOF SURVEY

UNDER

Application No. **20968** Permit No. **16414**

IN NAME OF

JAMES C. FOSTER

Surveyed **JUNE 10 1948**, by **JAS. E. BUNNELL**