


T.4S.R.2W.W.M.

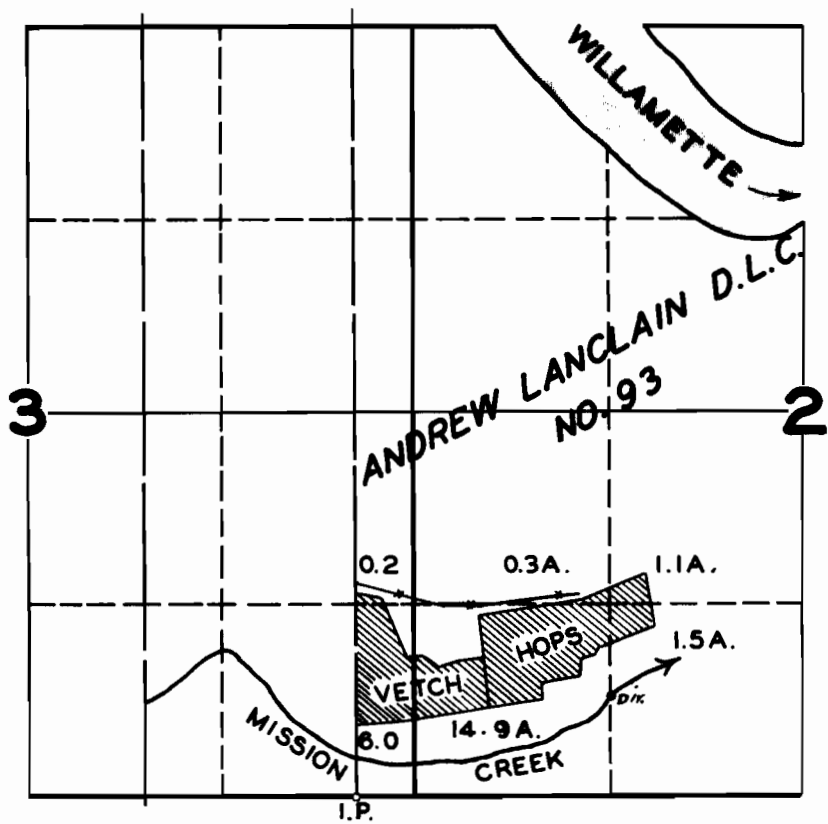

FINAL PROOF SURVEY UNDER

Application No. 21594 ... Permit No. 17077 ...
IN NAME OF

THOMAS JETTE

Surveyed APR. 16 1947, by JAS. E. BUNNELL