


T.3S.R.3W.W.M.

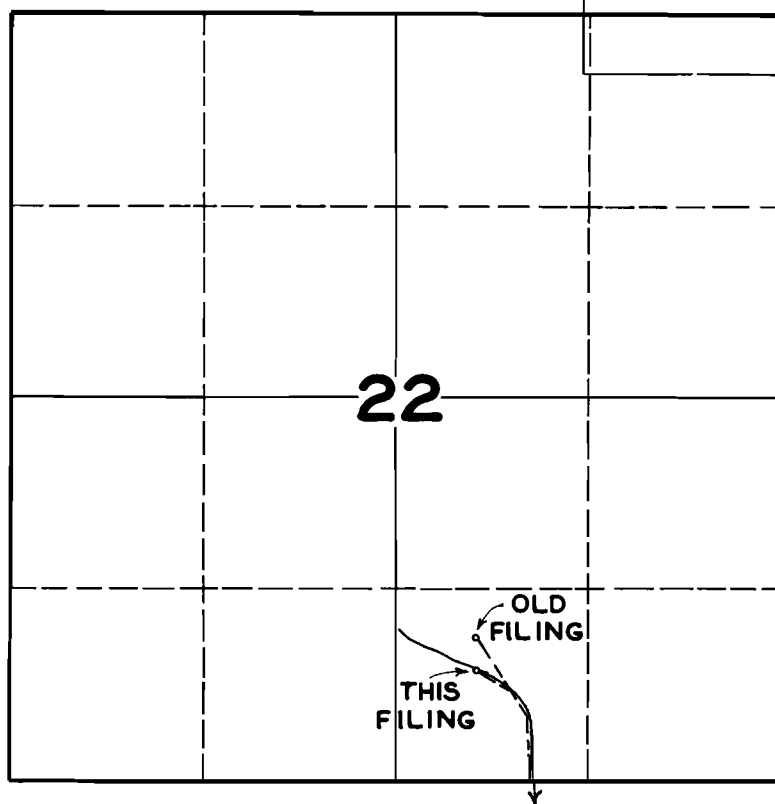

FINAL PROOF SURVEY

UNDER

Application No. **22077** Permit No. **17367**

IN NAME OF

CITY OF DUNDEE

Surveyed **MAY 14 1948**, by **JAS. E. BUNNELL**