


T.6S.R.2E.W.M.

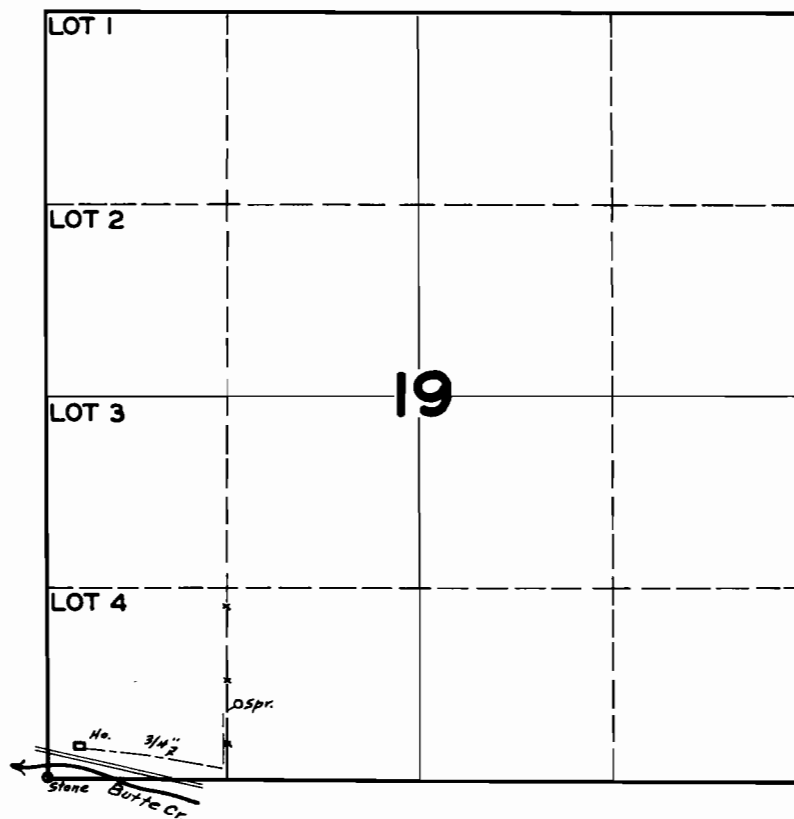

FINAL PROOF SURVEY
UNDER

Application No. 22466 Permit No. 17714

IN NAME OF

FRED L. GARRETT

Surveyed SEP. 3 1947, by JAS. E. BUNNELL