


# T.I.S.R.I.W.W.M.

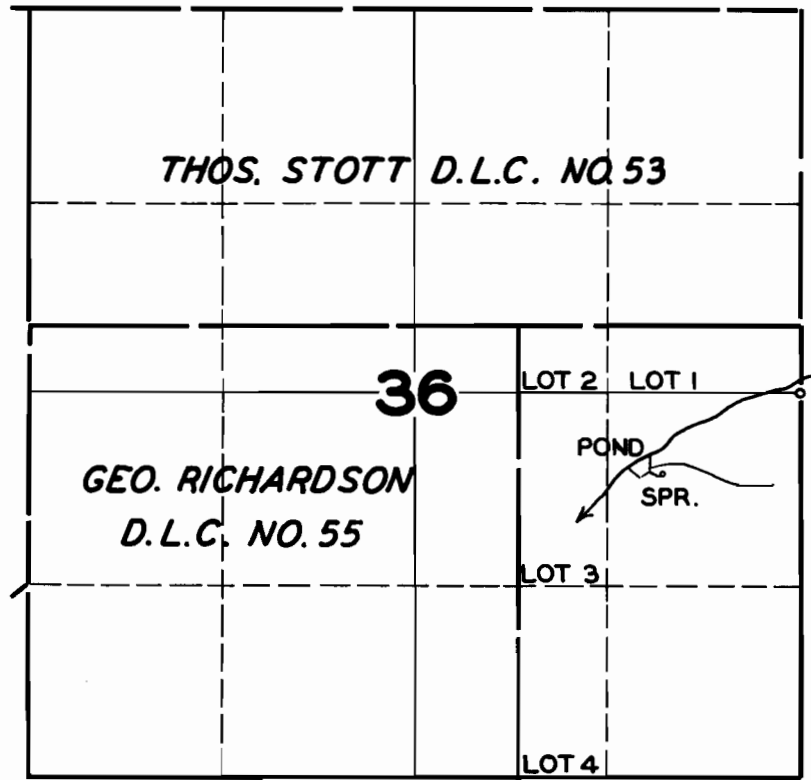

## FINAL PROOF SURVEY

UNDER

Application No. **22731** Permit No. **17928**

IN NAME OF

**PAUL M. SCHEFFER**

Surveyed **MAY 6** 1948, by **JAS. E. BUNNELL**