


T.6S.R.7W.W.M.

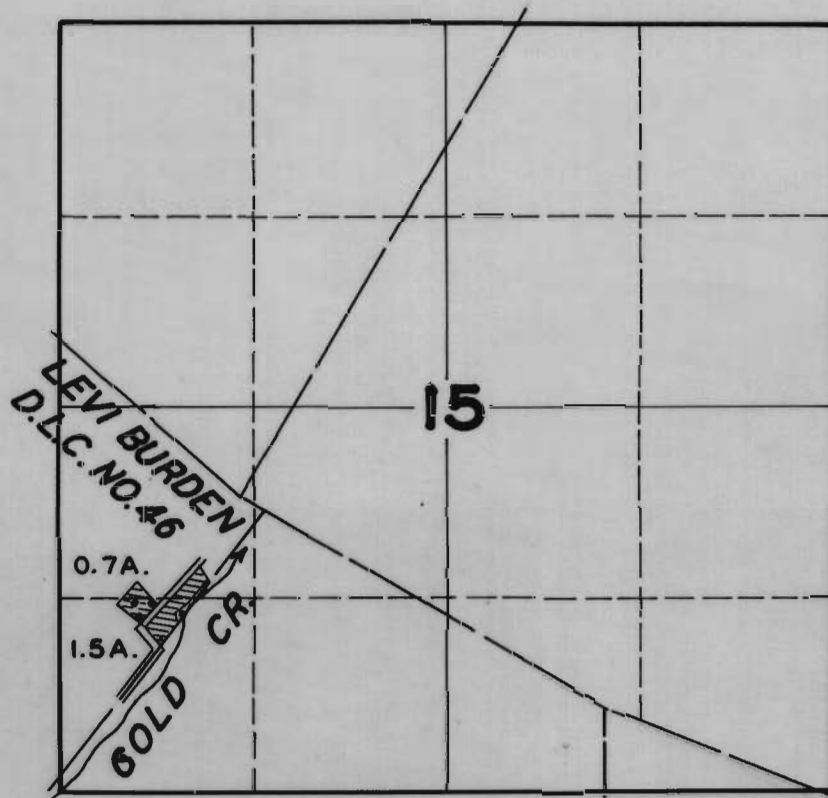

FINAL PROOF SURVEY
UNDER

Application No. **22938** Permit No. **18188**
IN NAME OF

T. J. WERTH

Surveyed **APR. 7, 1949**, by **JAS. E. BUNNELL**