


T.10S.R.2W.W.M.

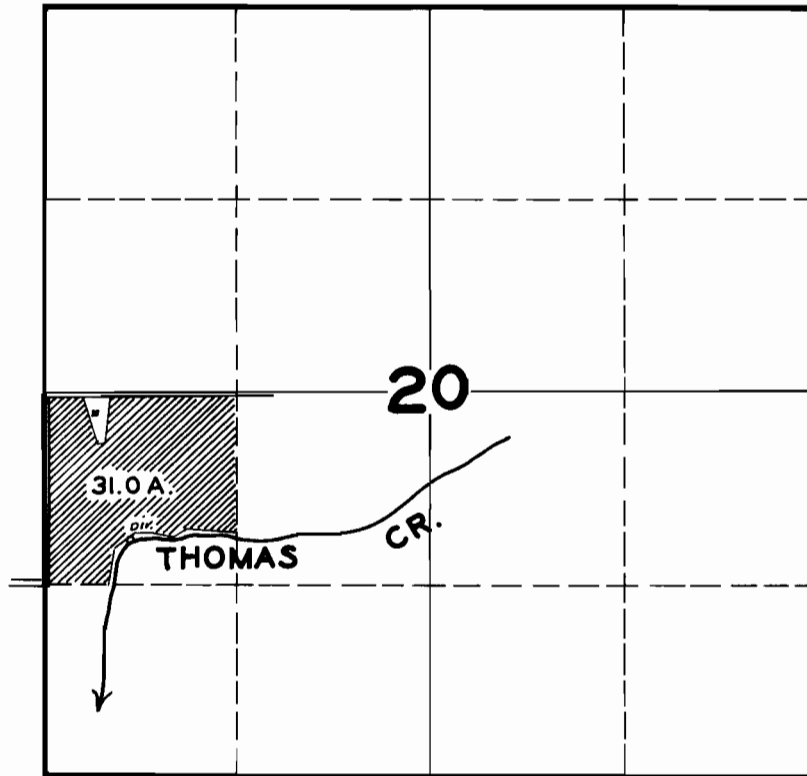

**FINAL PROOF SURVEY
UNDER**

Application No. 17724 Permit No. 13432

IN NAME OF

H.E. ROTHROCK

Surveyed MAY 8 1947, by JAS. E. BUNNELL