


T. 29S. R. 5W. W.M.

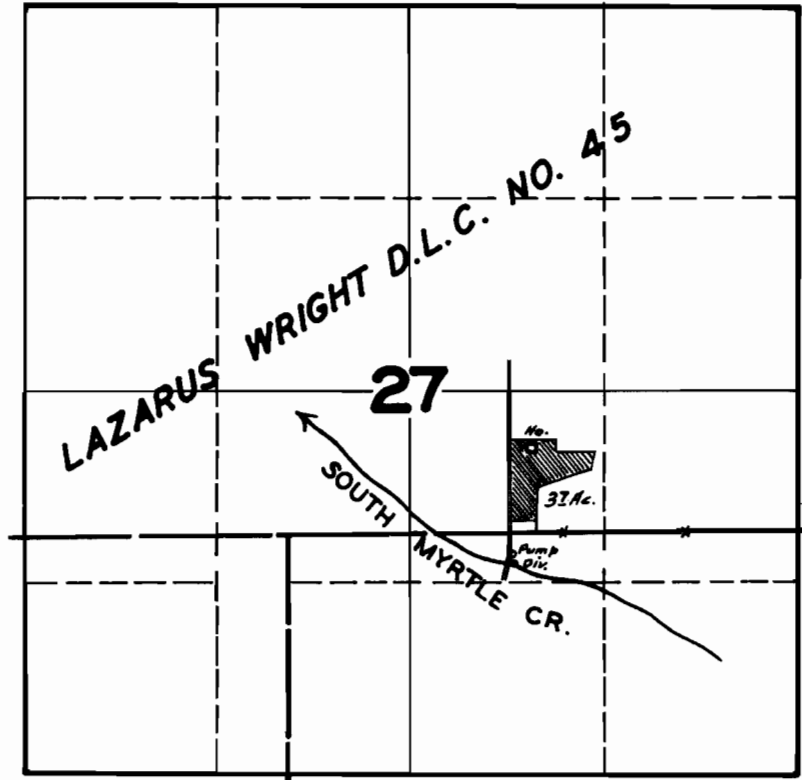

FINAL PROOF SURVEY UNDER

Application No. 19425 Permit No. 14959

IN NAME OF

L. E. HOWARD

Surveyed JUNE 4 1947, by JAS. E. BUNNELL