


T. 11 S. R. 6 W. W. M.

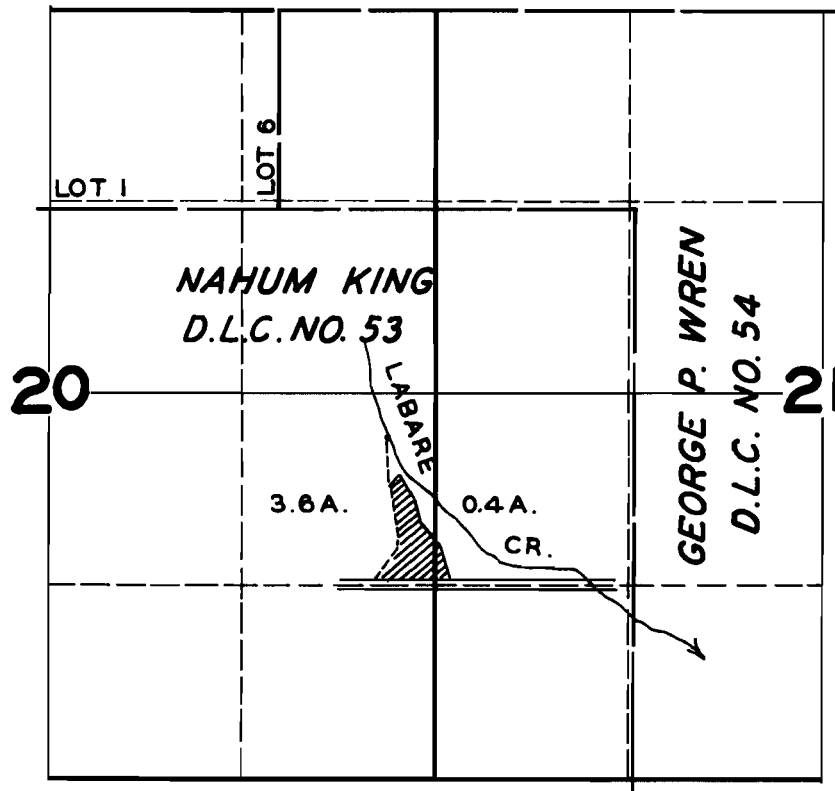

FINAL PROOF SURVEY
UNDER

Application No. **19379** ... Permit No. **14995**
IN NAME OF

WILLIAM MULLER

Surveyed **JULY 5, 1948**, by **JAS. E. BUNNELL**