


T.4S.R.3W.W.M.

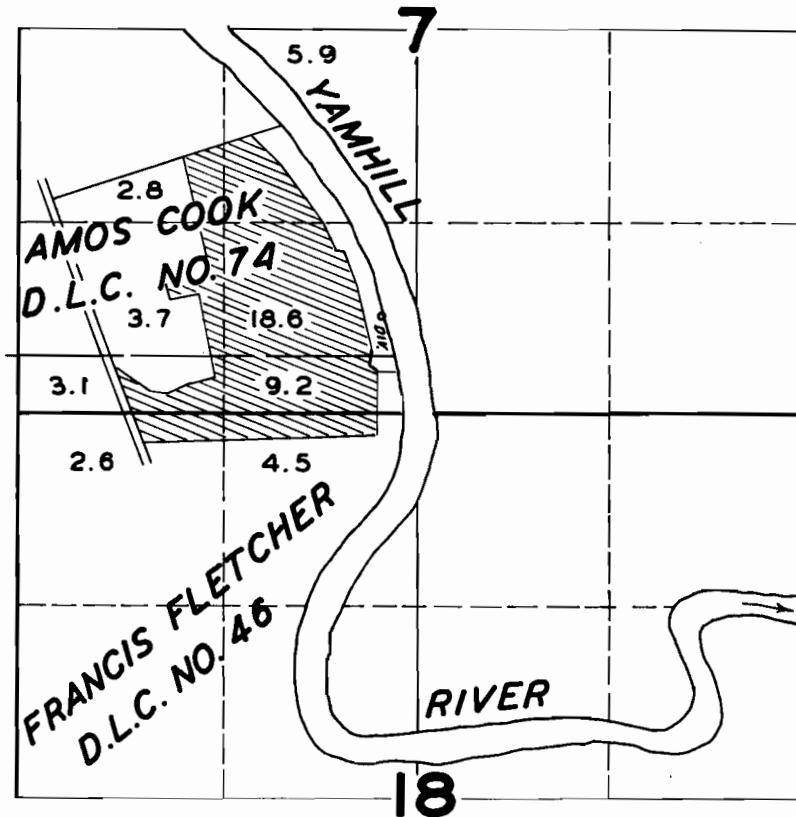

FINAL PROOF SURVEY

UNDER

Application No. 20991... Permit No. 16430...

IN NAME OF

HARVEY F. MEYER & CLARA H. MEYER

Surveyed MAY 6... 1949, by JAS. E. BUNNELL