


T. 11 S. R. 4 W. W. M.

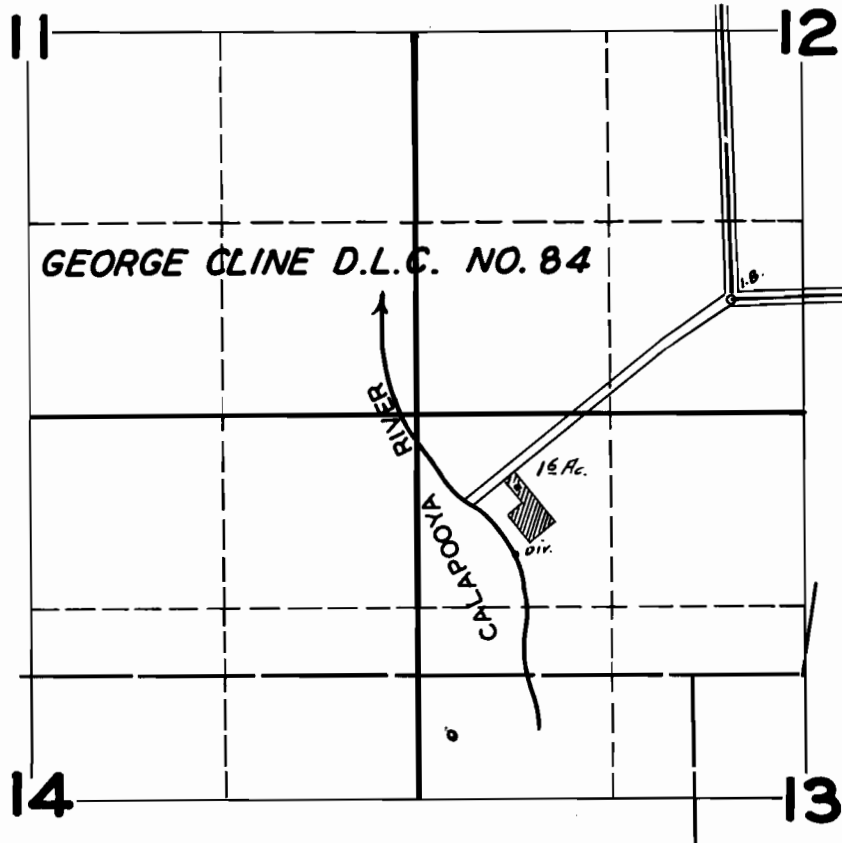

FINAL PROOF SURVEY
UNDER

Application No. 21890 Permit No. 17209

IN NAME OF

RICHARD SPENCER

Surveyed AUG. 26 1947, by JAS. E. BUNNELL