


T.22S.R.9W.W.M.

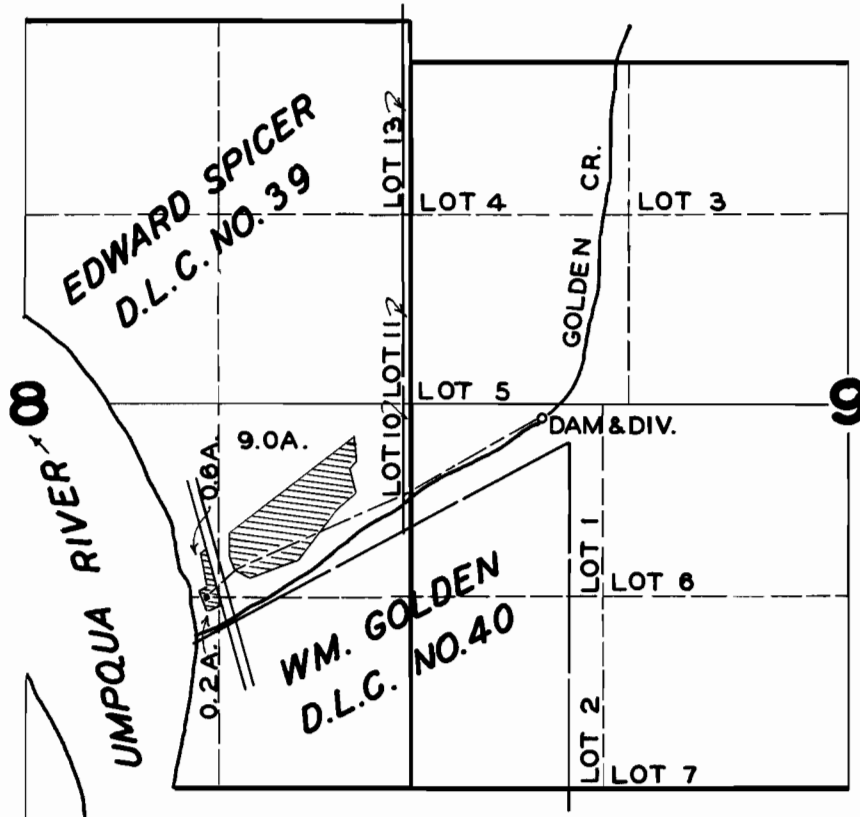

FINAL PROOF SURVEY

UNDER

R-18968

R-754

Application No. **18969** Permit No. **14566**

IN NAME OF

ARCHIE C. LOUD

Surveyed **JULY 13, 1948**, by **JAS. E. BUNNELL**