


T.13S. R.3W. W.M.

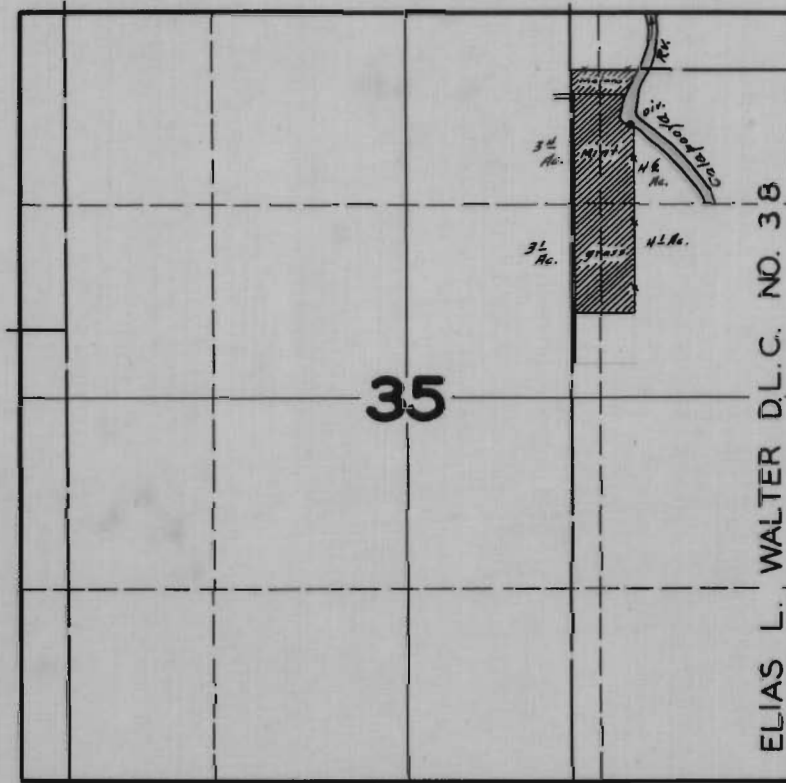

FINAL PROOF SURVEY
UNDER

Application No. 20168 Permit No. 15725

IN NAME OF
R. A. WARD

Surveyed AUG. 4, 1945, by [Signature]