


# T. 15. R. 4 W. W. M.

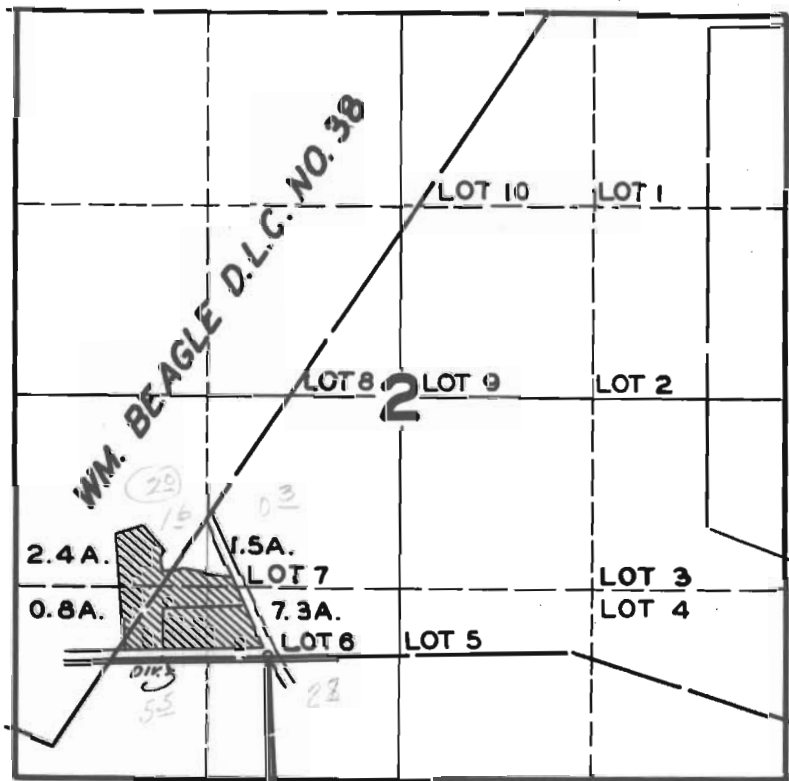

## FINAL PROOF SURVEY UNDER

Application No. 21,235 Permit No. 16644  
IN NAME OF

J. E. ALEXANDER

Surveyed MAY 18, 1948, by JAS. E. BUNNELL