


# T.28S. R.6W.W.M.

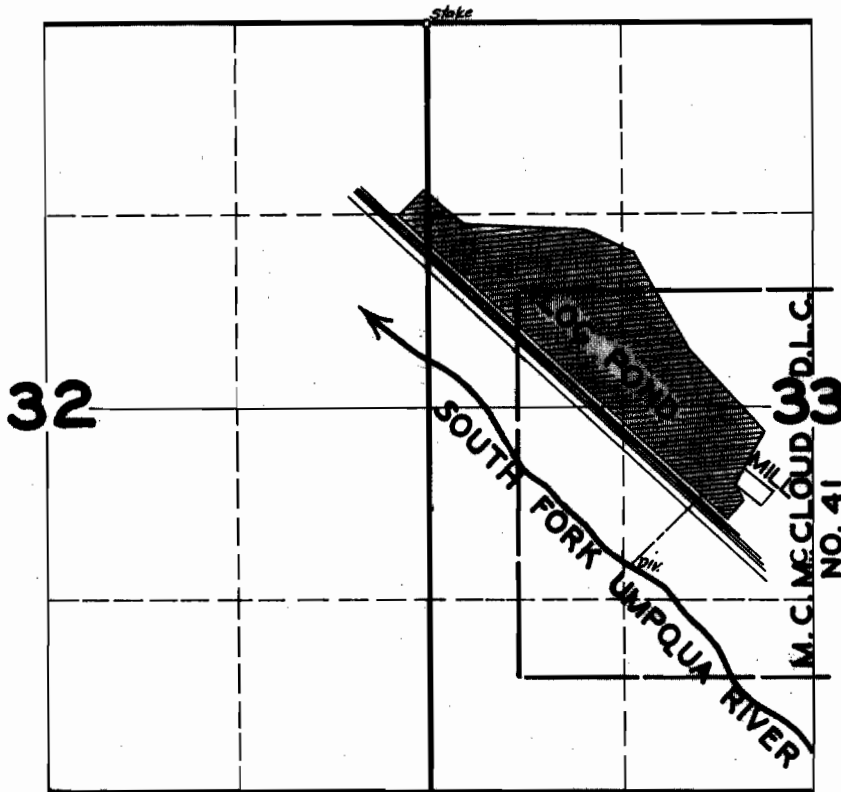

## FINAL PROOF SURVEY

UNDER

R-20855

R-817

Application No. 20856 Permit No. 16335

IN NAME OF

ROSEBURG LUMBER COMPANY

Surveyed JUNE 2, 1947, by JAS. E. BUNNELL