


T.28S.R.6W.W.M.

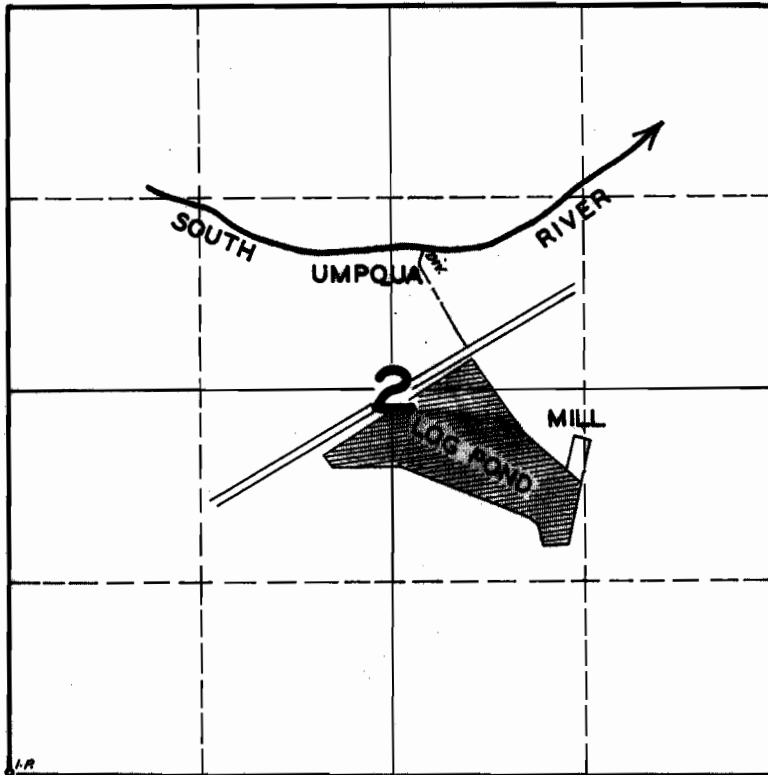

FINAL PROOF SURVEY

UNDER

R-21011 R-822
Application No. 21012 Permit No. 16477

IN NAME OF

UMPQUA PLYWOOD CORPORATION

Surveyed JUNE 2 1947, by JAS. E. BUNNELL