


T. 7S. R. 5W.W.M.

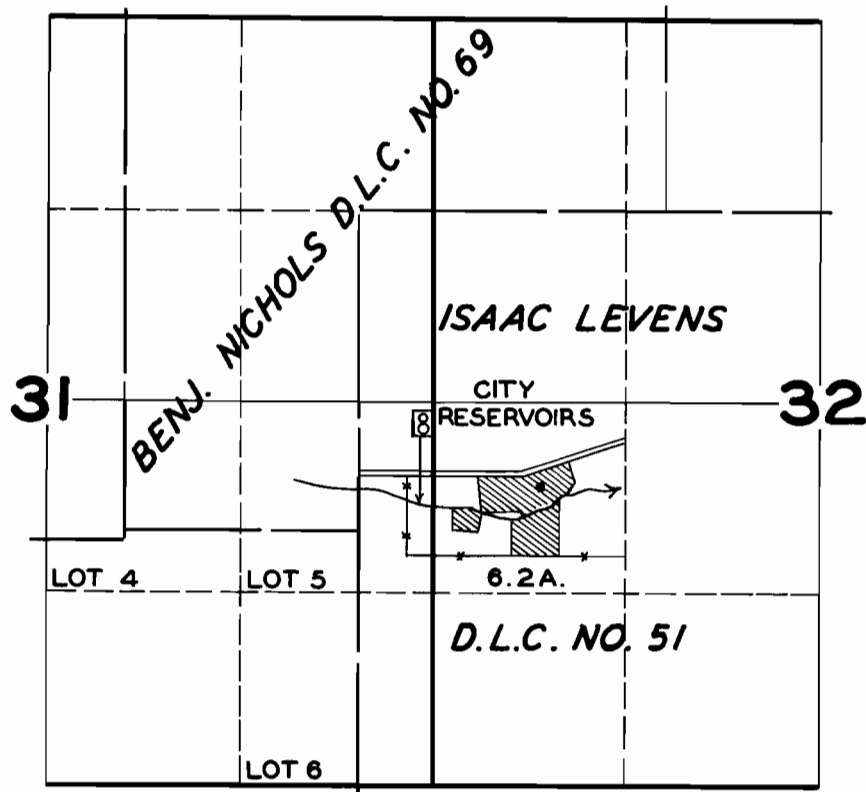

FINAL PROOF SURVEY
UNDER

Application No. **16209** Permit No. **12024**
IN NAME OF

HERMAN & DOROTHY VAN WELL

Surveyed **MAR. 26 1948**, by **JAS. E. BUNNELL**