


T.25 S.R.13W.W.M.

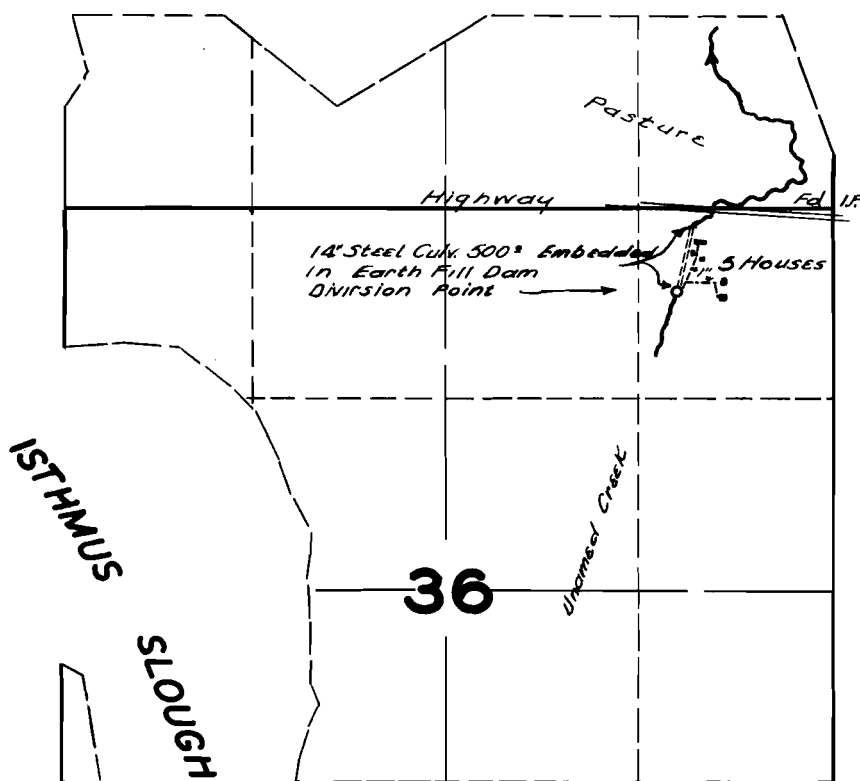

FINAL PROOF SURVEY

UNDER

Application No. **16895**..... Permit No. **12710**.....

IN NAME OF

ERNEST PORTER.....

Surveyed **AUG. 29, 1949**, by **H.L. GOFFMAN**