


# T.40S.R.13W.W.M.

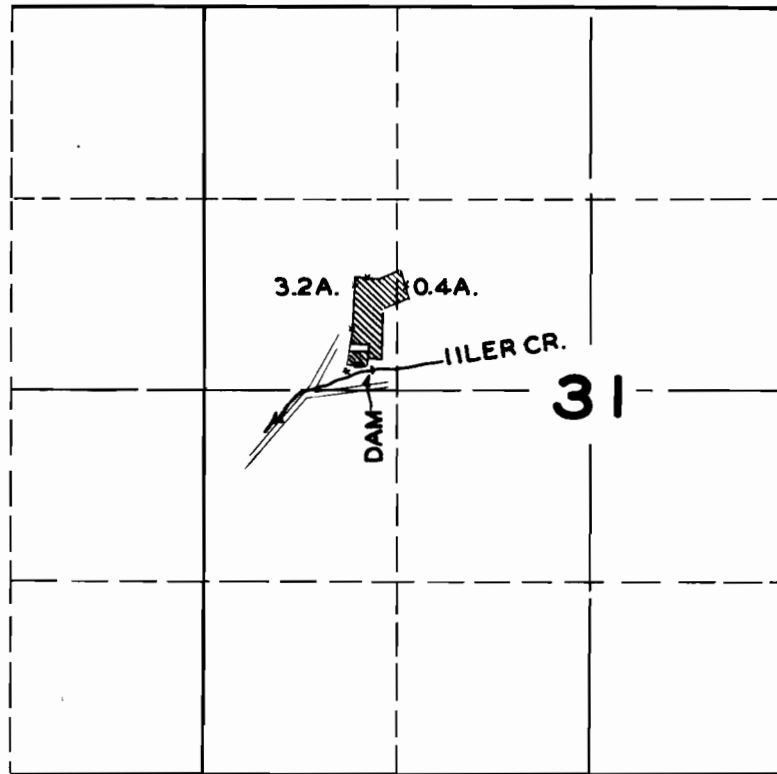

## FINAL PROOF SURVEY UNDER

Application No. 19517..... Permit No. 15110.....  
IN NAME OF

RUBY E. DODGE

Surveyed AUG. 3, 1949, by H.L. COFFMAN