


Per 13286
17255

FINAL PROOF SURVEY UNDER

APPLICATION NO 17590 PERMIT NO 13286

GEORGE YOKOM

T.13S R.29E.W.M.

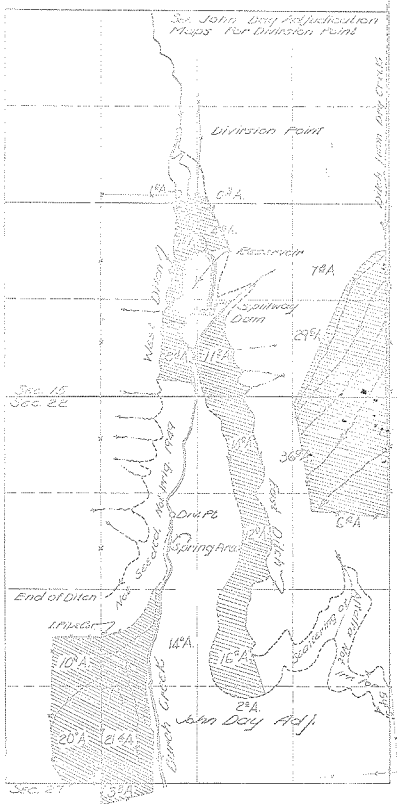

SURVEYED OCT. 24 1949 BY H.L. COFFMAN
1949 H