


T.3S.R.3W.W.M.

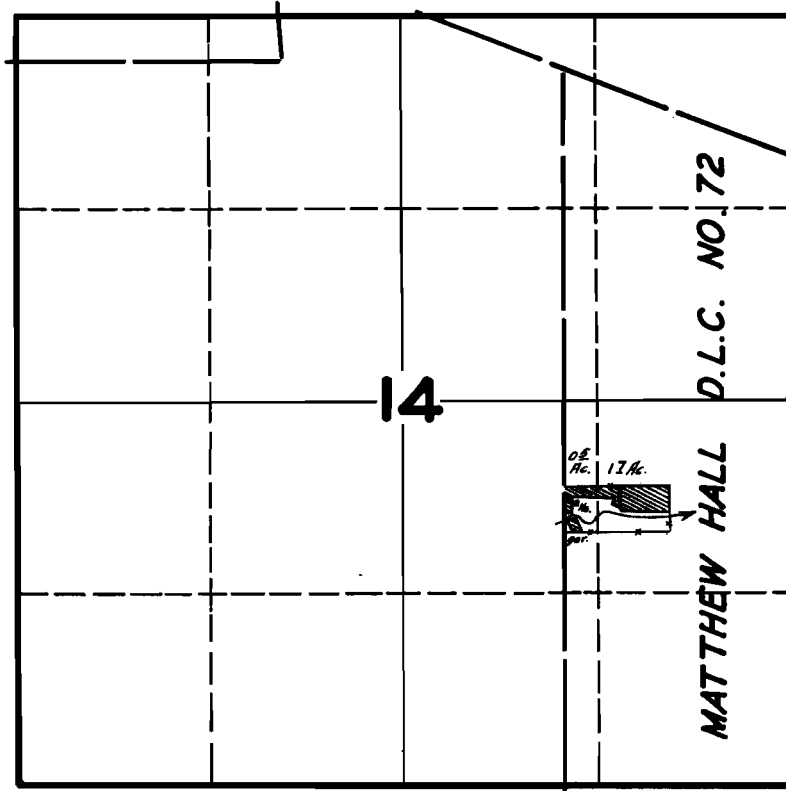

**FINAL PROOF SURVEY
UNDER**

Application No. 19954 Permit No. 15516

IN NAME OF

JACK CLYBURN

Surveyed MAR. 7, 1946, by [Signature]