


T.4S.R.5W.W.M.

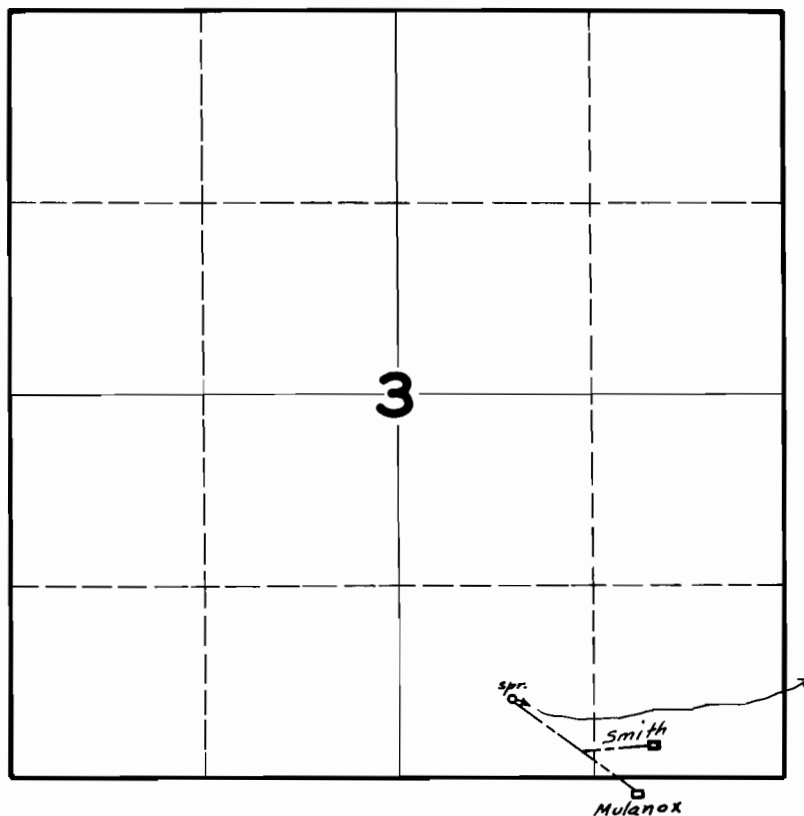

FINAL PROOF SURVEY
UNDER

Application No. **19869** Permit No. **15420**
IN NAME OF

J.R. & PEARL DEVLAN 1/2 - CHAS. G. & GRACE SMITH 1/2

Surveyed **MAY 6** 1947, by **JAS. E. BUNNELL**