


T. 28 S., R. 12 W. W.M.

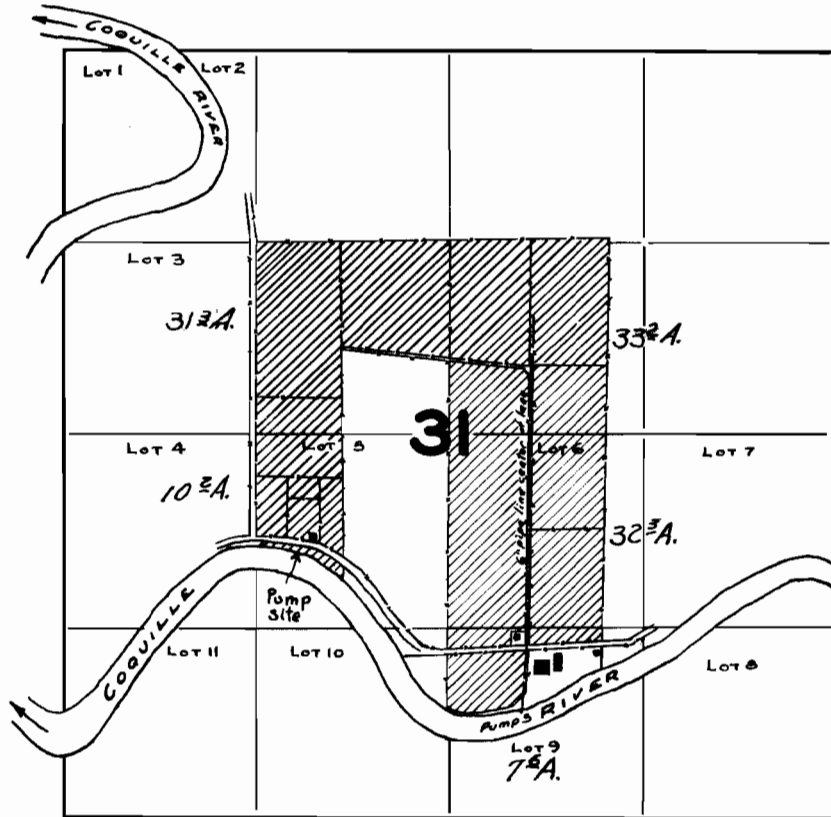

FINAL PROOF SURVEY
UNDER

Application No. 18019 Permit No. 13690

IN NAME OF

Martin M. Schmidt

Surveyed Aug. 25, 1943, by Geo. W. Aderman

Final inspection Sept. 13, 1949 H.L. Coffman