


T.3S.R.5W.W.M.
T.3S.R.4W.W.M.

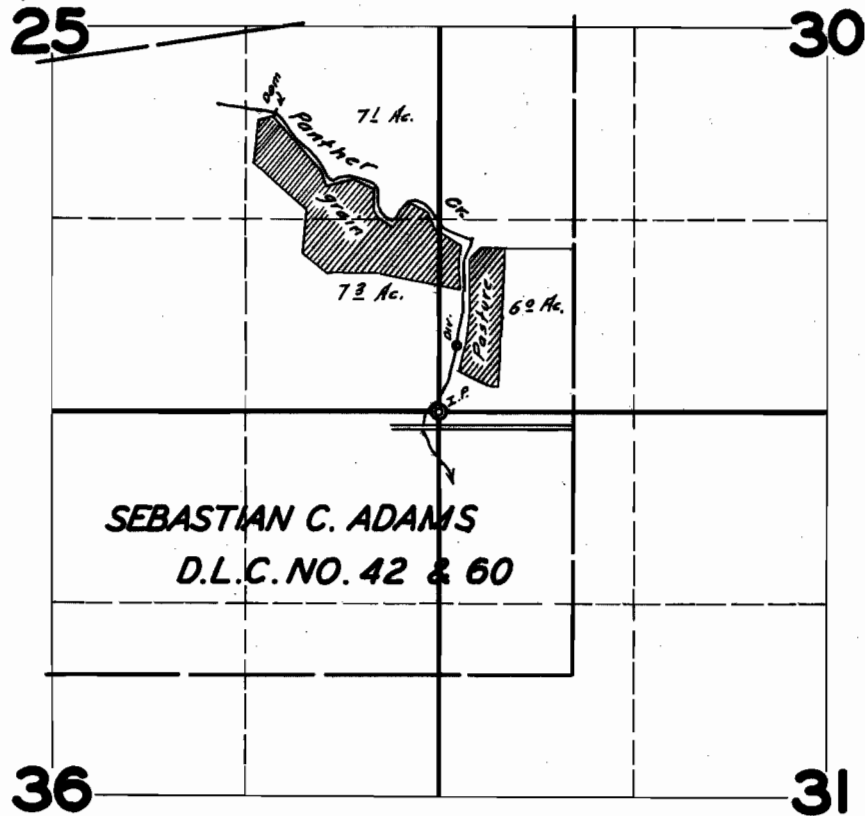

FINAL PROOF SURVEY
UNDER

Application No. 18130 Permit No. 13778

IN NAME OF

RICHARD R. BURNHAM

Surveyed JULY 2, 1945, by