


T.22S.R.9W.W.M.

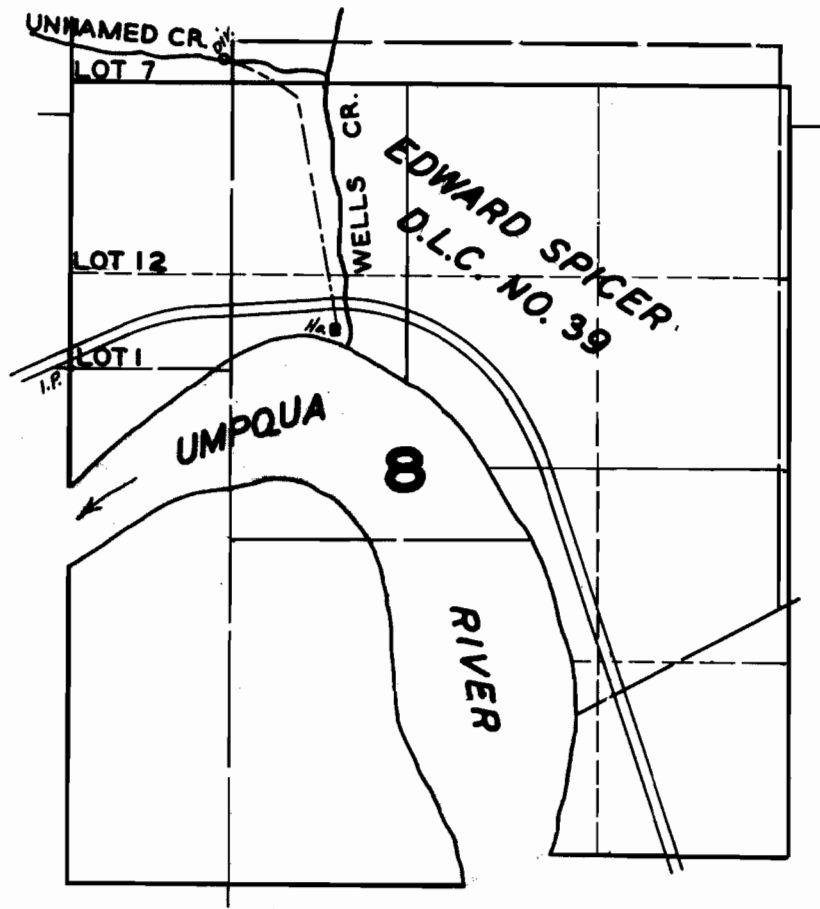

FINAL PROOF SURVEY
UNDER

Application No. 18340 Permit No. 13972
IN NAME OF

PAUL APPLGATE

Surveyed JUL. 13. 1948, by JAS. E. BUNNELL