


T.16S.R.5E.W.M.

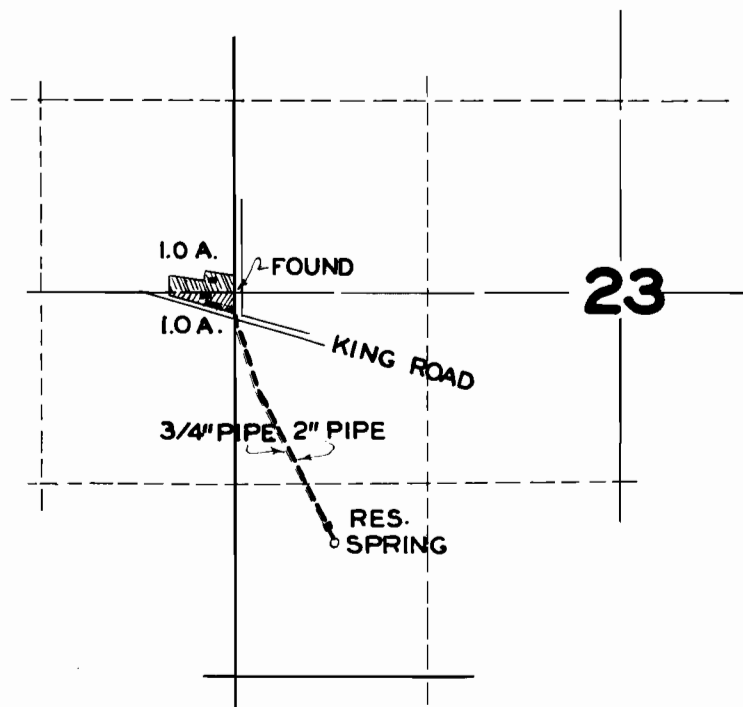

FINAL PROOF SURVEY

UNDER

Application No. 18414... Permit No. 14203...

IN NAME OF

D. R. DYAS

Surveyed 6/24 1949, by H. L. COFFMAN.