


Per 14314  
14315  
17264  
17265

T.14S.R.31E.W.M.

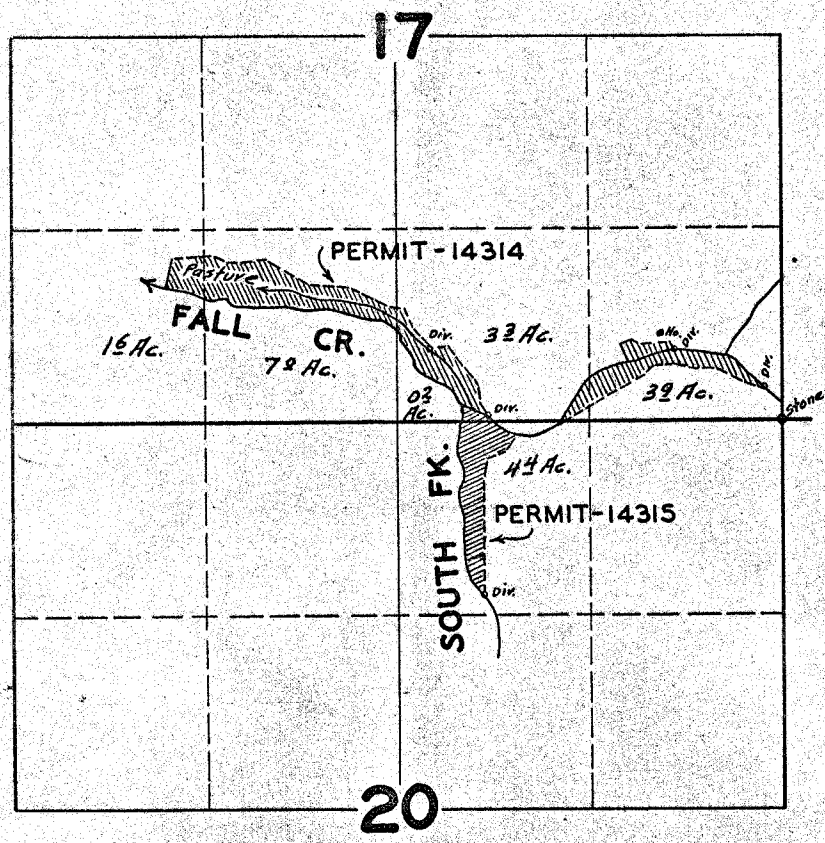

FINAL PROOF SURVEY

UNDER

18687

14314

Application No. 18688 Permit No. 14315

IN NAME OF

JAMES A. WYLLIE

Surveyed APR. 25 1947, by JAS. E. BUNNELL