


Per 14314
14315
17264
17265

T.14S.R.31E.W.M.

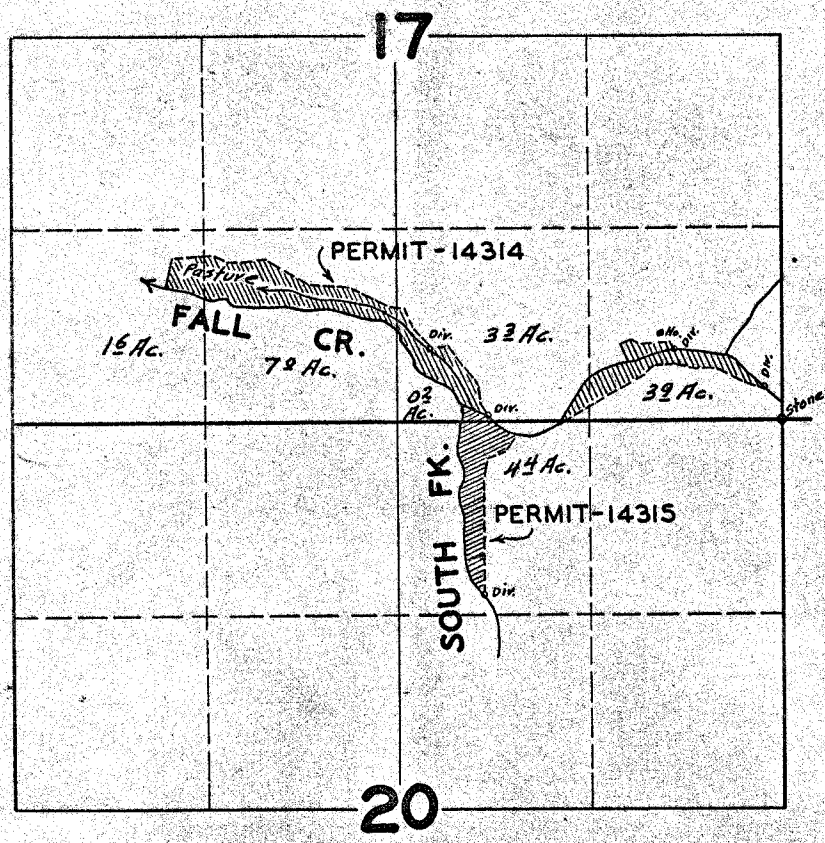

FINAL PROOF SURVEY

UNDER

18687 14314
Application No. 18688 Permit No. 14315

IN NAME OF

JAMES A. WYLLIE

Surveyed APR. 25 1947, by JAS. E. BUNNELL