


# T.10S.R.30E.W.M.

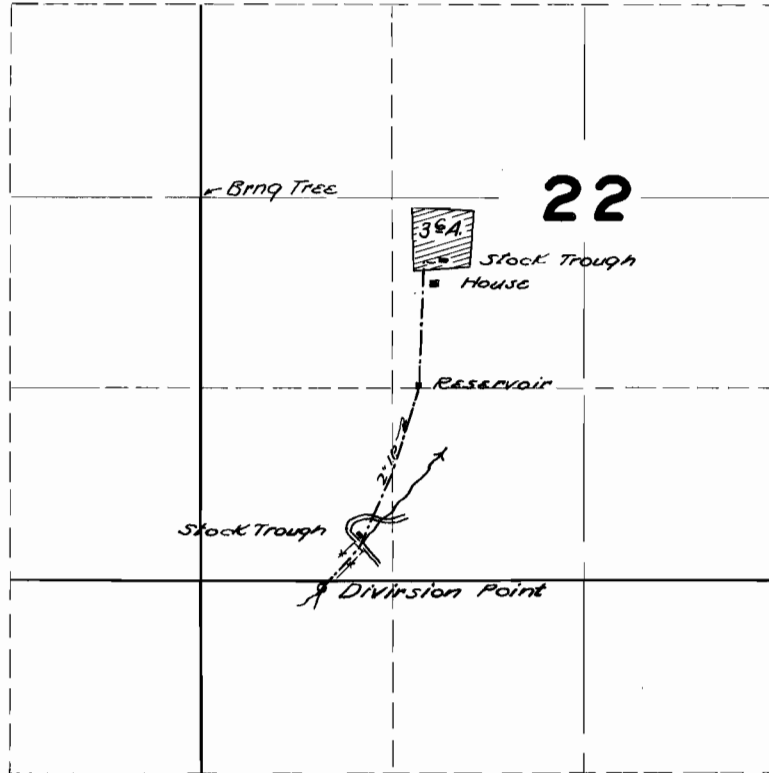

## FINAL PROOF SURVEY UNDER

Application No. **18694** Permit No. **14377**  
IN NAME OF

**JOHN L. CARTER**

Surveyed **NOV. 2, 1949**, by **H.L. COFFMAN**.