


Per 14395
17267

T.10S.R.30E.W.M.

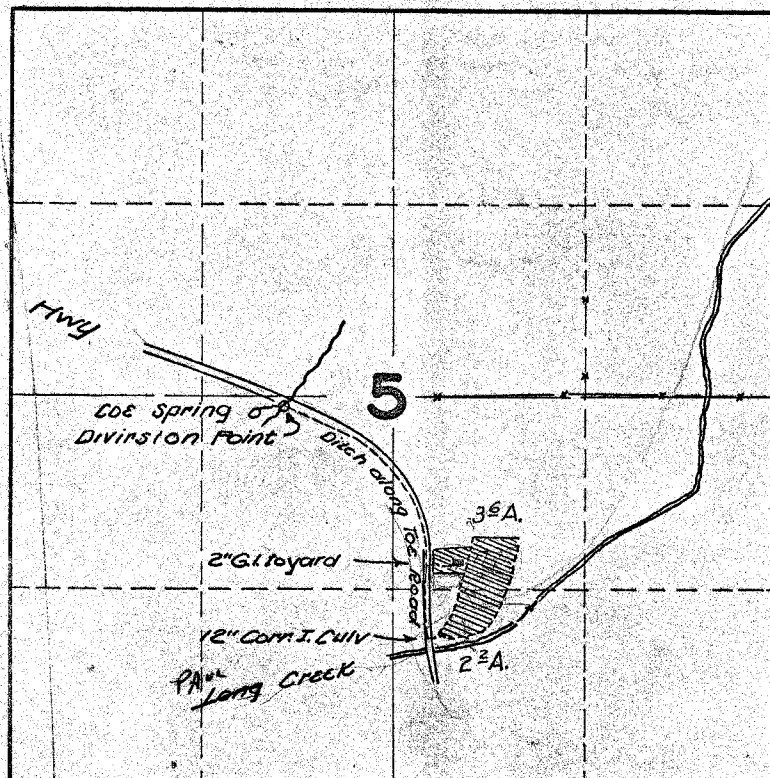

FINAL PROOF SURVEY
UNDER

Application No. 18507..... Permit No. 14395...
IN NAME OF

.....R.W. SHAW & ELLA G. SHAW.....

Surveyed OCT. 26 1949, by H.L. COFFMAN..