


T.25S.R.12W.W.M.

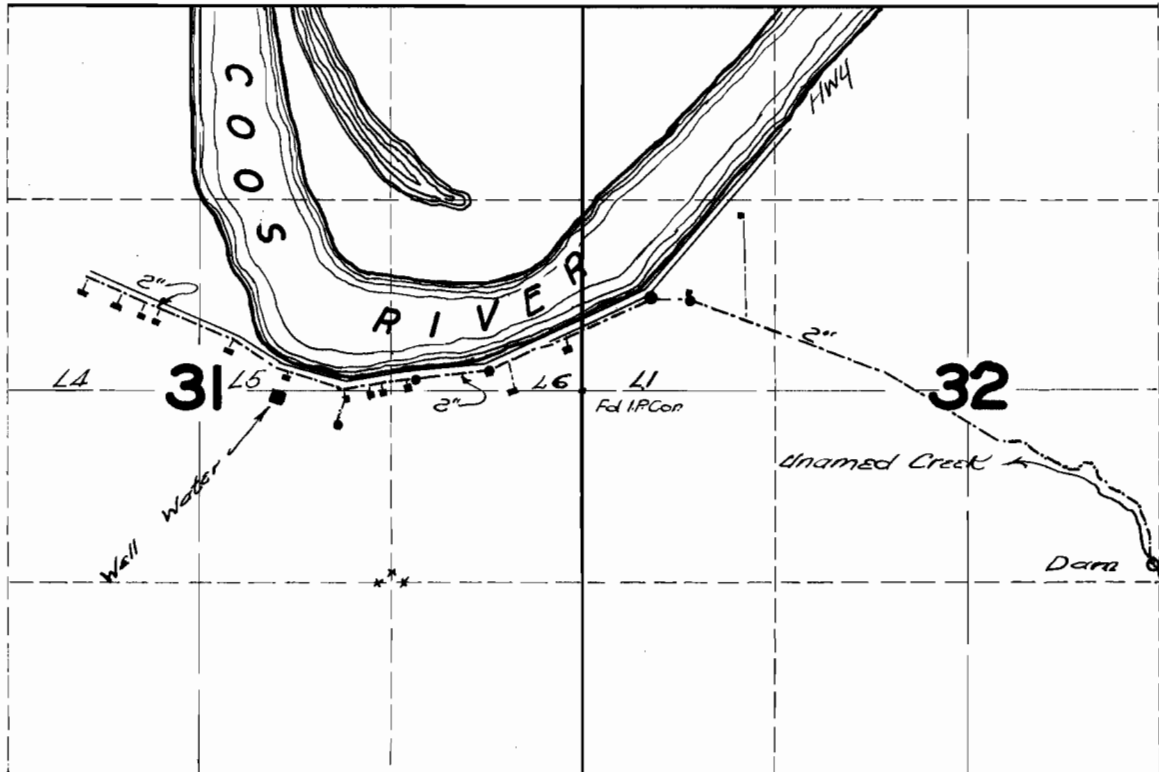

FINAL PROOF SURVEY UNDER

Application No. **18737**..... Permit No. **14409**
IN NAME OF

DENNIS M^cCARTHY

Surveyed **SEP. 2**... 1949, by **H.L. COFFMAN**...

- Houses
- Stock Troughs