


Per 14631
17269

T.I.S.R. 28 E.W.M.

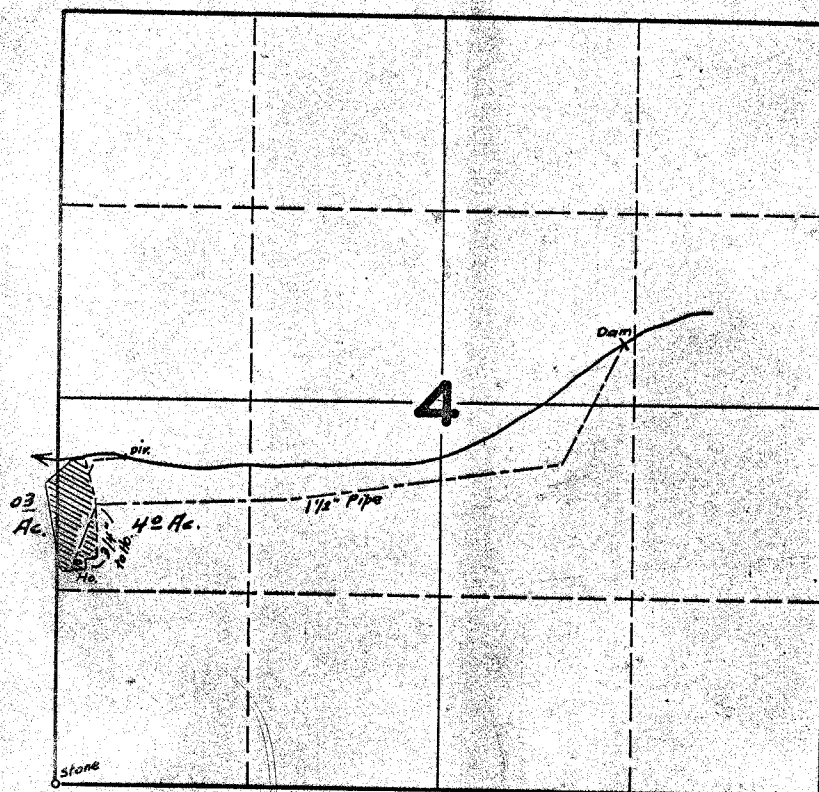

FINAL PROOF SURVEY UNDER

Application No. 19024 Permit No. 14631

IN NAME OF

HERMAN THOMPSON

Surveyed APR. 26 1947, by JAS. E. BUNNELL