


T.4S.R.IE.&IW.W.M.

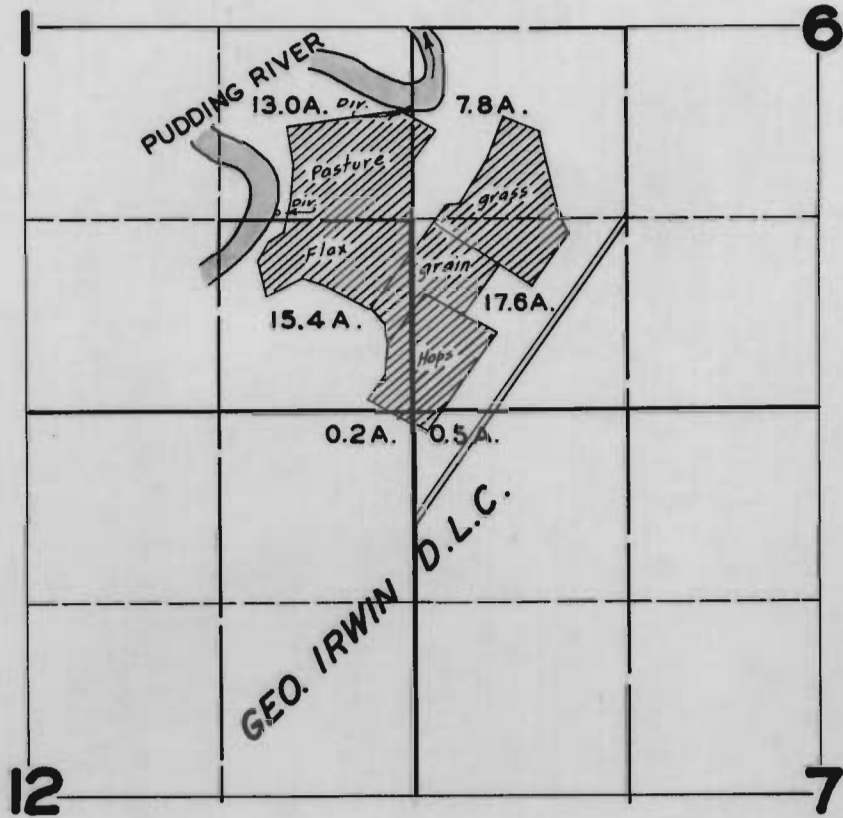

FINAL PROOF SURVEY

UNDER

Application No. 19215 Permit No. 14806

IN NAME OF

ANDERSON BROS.

Surveyed JUN. 12, 1947, by JAS. E. BUNNELL