


T.16S.R.5W.W.M.

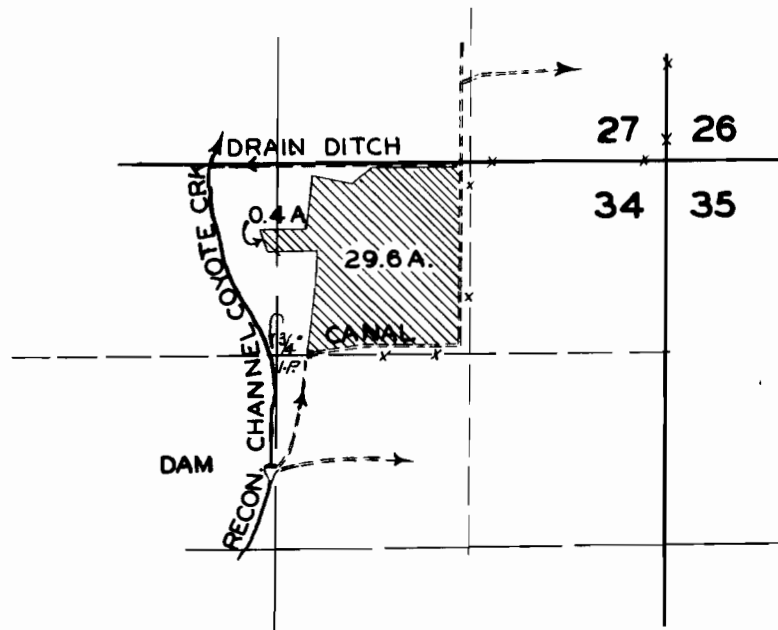

FINAL PROOF SURVEY

UNDER

Application No. 19444. Permit No. 15013.
IN NAME OF

CEO BJORSET

Surveyed MAY 26 1949, by H.L. COFFMAN