


T.4S.R.5W.W.M.

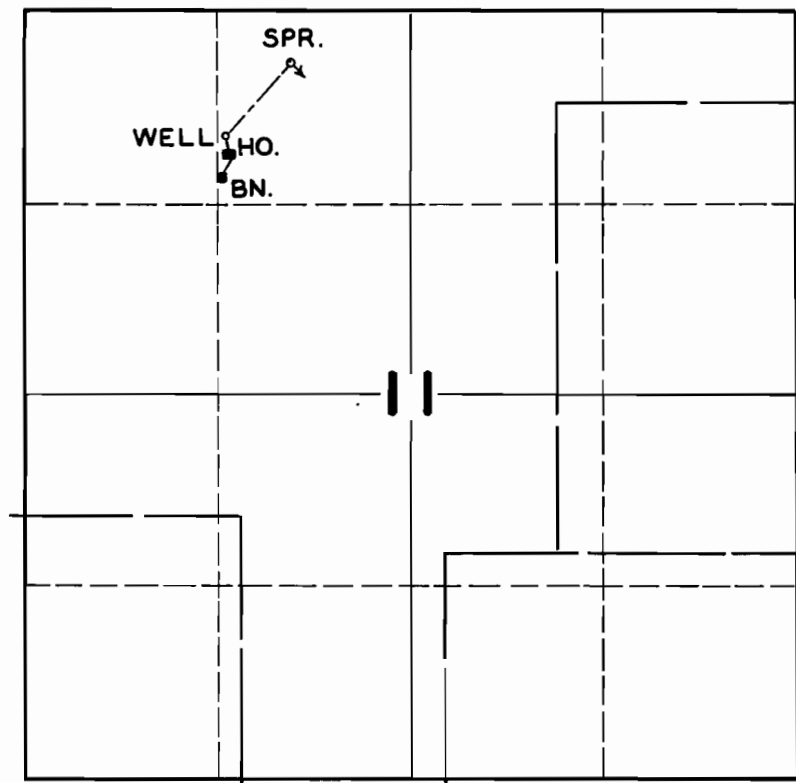

FINAL PROOF SURVEY
UNDER

Application No. **19561** Permit No. **15144**
IN NAME OF

HARRY A. & RUTH R. FREDRICKS

Surveyed **AUG. 26 1948**, by **JAS. E. BUNNELL**