


# T.13S.R.6W.W.M.

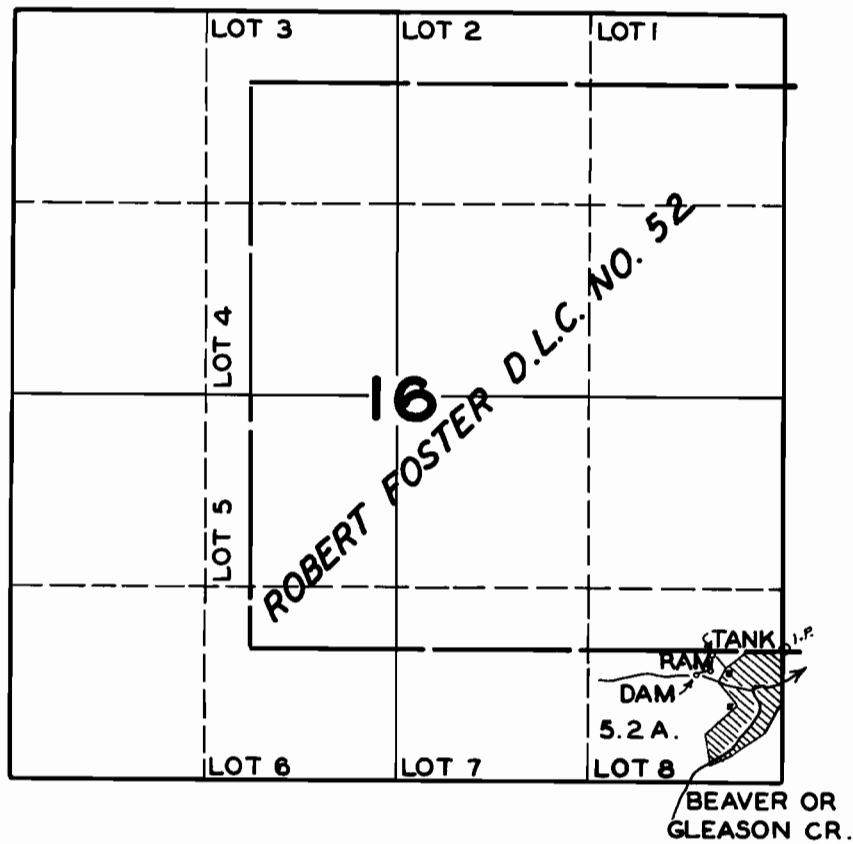

## FINAL PROOF SURVEY

UNDER

Application No. 19591    Permit No. 15179

IN NAME OF

**M.C. & MARY S. SMITH**

Surveyed JUNE 25 1948, by JAS. E. BUNNELL