


T.9S.R.1E.W.M.

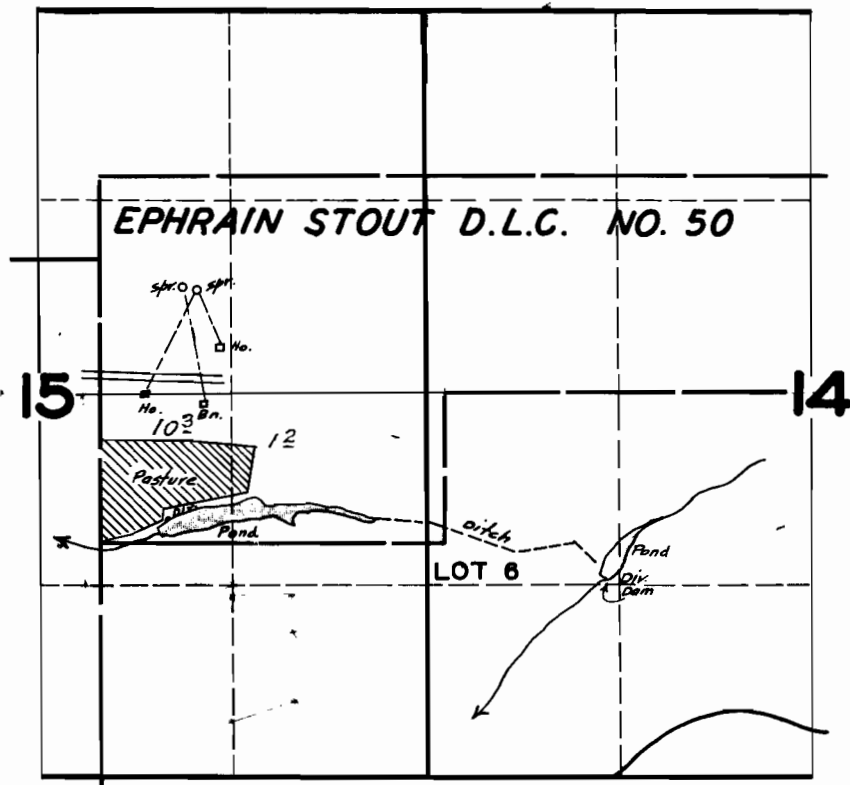

FINAL PROOF SURVEY

UNDER

Application No. 19794 Permit No. 15371

IN NAME OF

CHESTER J. BLUM

Surveyed OCT. 14 1947, by JAS. E. BUNNELL