


T.6S. R.10W.W.M.

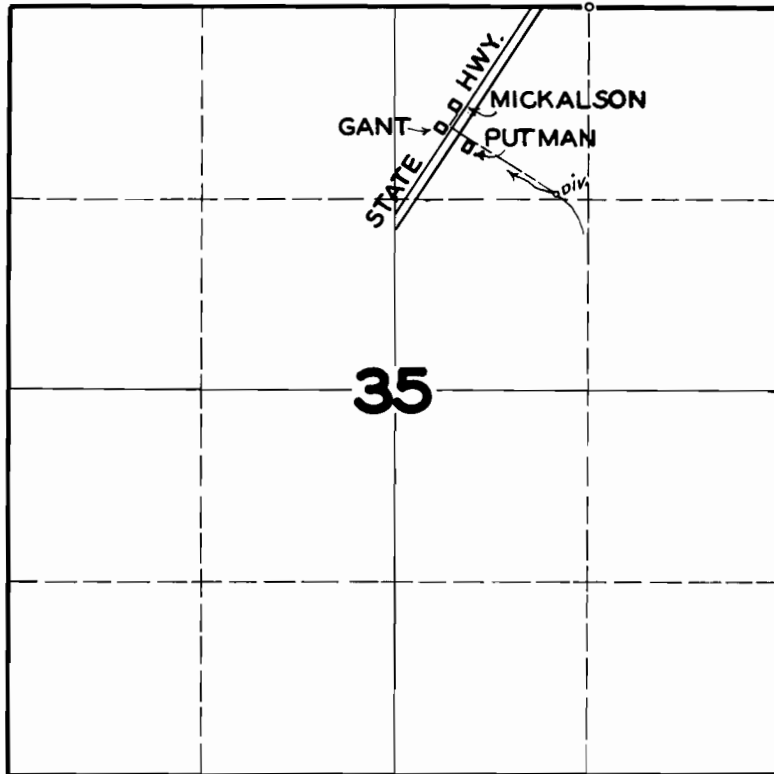

FINAL PROOF SURVEY
UNDER

Application No. 19895 Permit No. 15474
IN NAME OF

HENRY GANT - KEN MICKALSON - R. ROY PUTMAN & MARIE M. PUTMAN

Surveyed AUG. 11, 1948, by JAS. E. BUNNELL