


T.26S.R.3W.W.M.

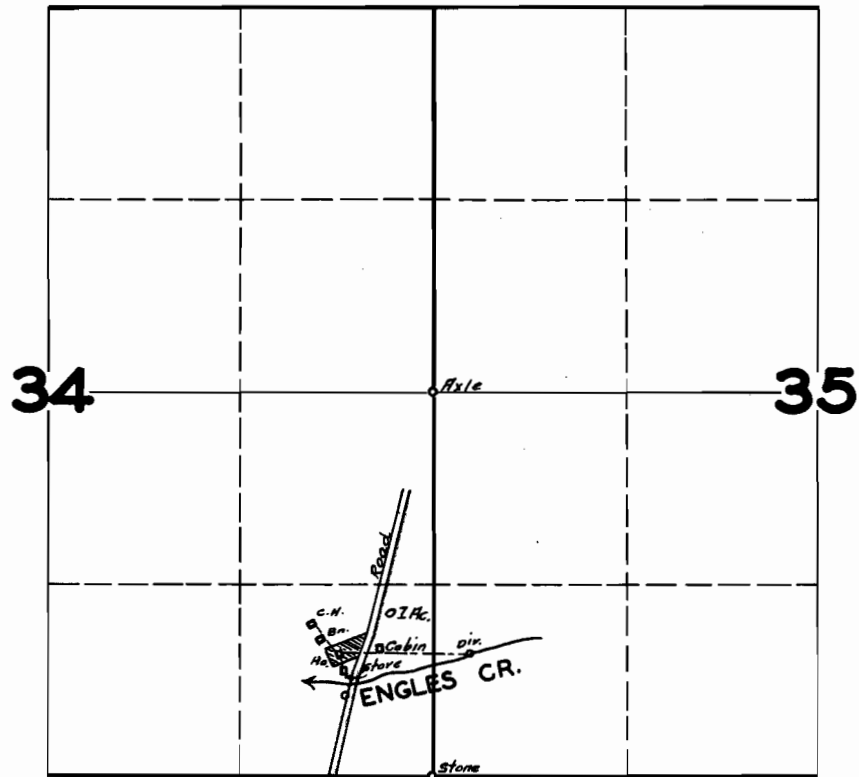

**FINAL PROOF SURVEY**  
UNDER

Application No. 19912 Permit No. 15488

IN NAME OF

LEE ENGELS & GLADYS ENGELS

Surveyed JULY 8, 1947, by JAS. E. BUNNELL