


**T.28S. R.8W.W.M.**

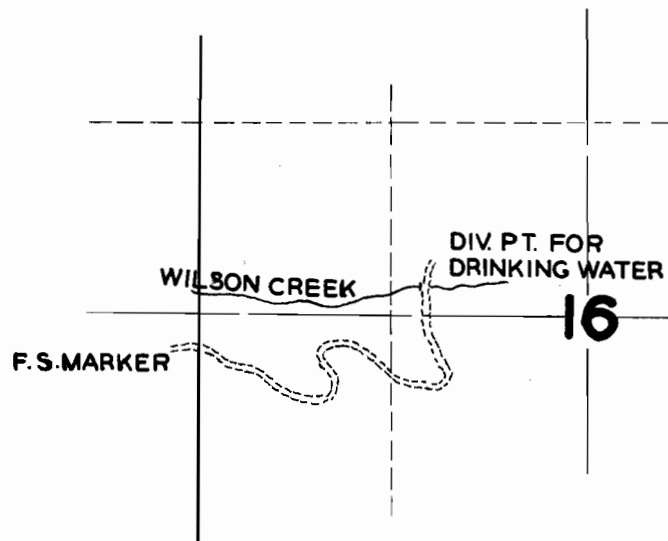

**FINAL PROOF SURVEY**  
UNDER

Application No. **19957** Permit No. **15528**  
IN NAME OF

**DOUGLAS CO. OREGON**

Surveyed **JULY 8 1949**, by **H.L. COFFMAN**