


T.22S.R.1W.W.M.

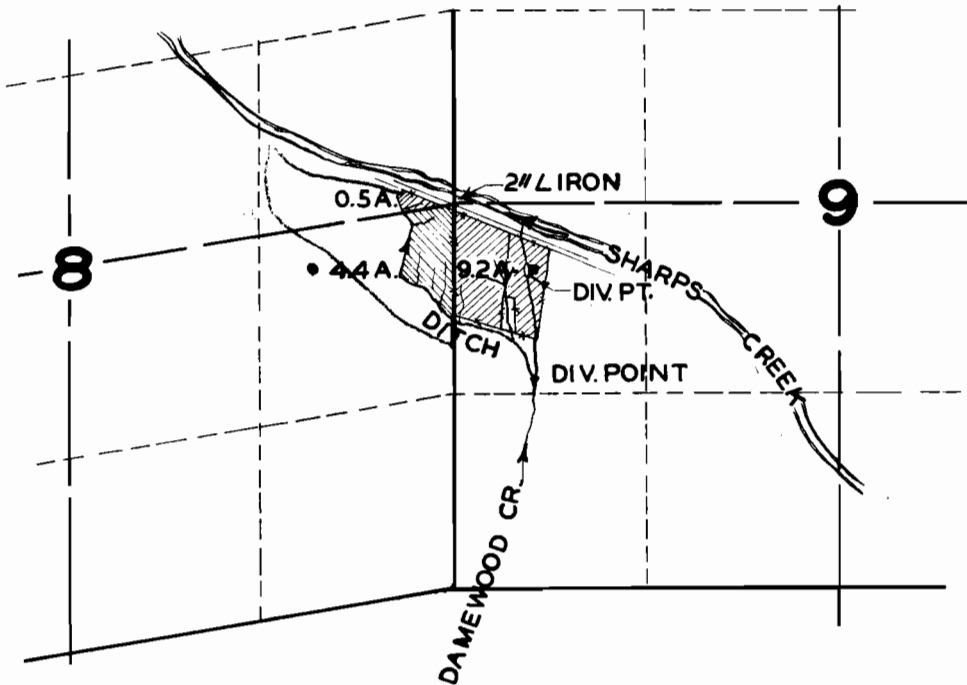

FINAL PROOF SURVEY

UNDER

Application No. 20096... Permit No. 15657...

IN NAME OF

ALEX. GAROUTTE

Surveyed JUNE 16 1949, by H.L. COFFMAN...