


T.27 S.R.2W.W.M.

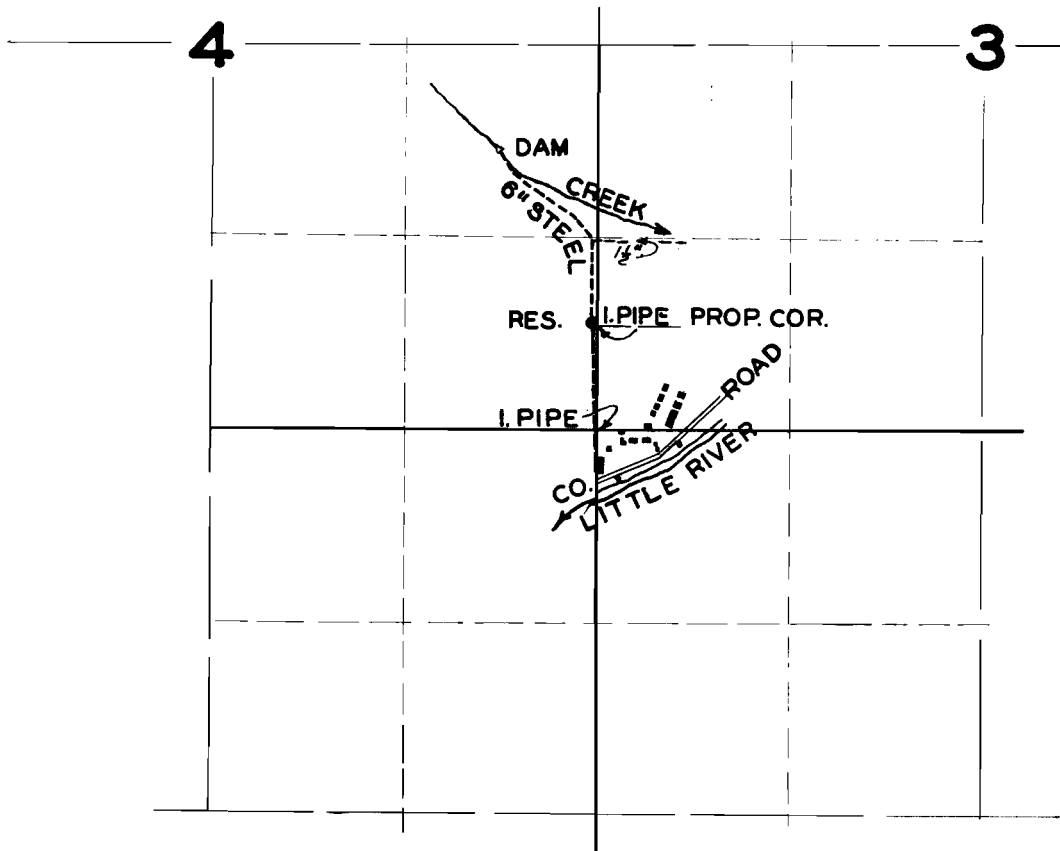

FINAL PROOF SURVEY UNDER

Application No. *20202* Permit No. *15753*
IN NAME OF

ASSOCIATED PLYWOOD MILLS INC.

Surveyed *JUL. 14 1949*, by *H. L. COFFMAN*