


Per 15762  
17283

# T.9S.R.27E.W.M.

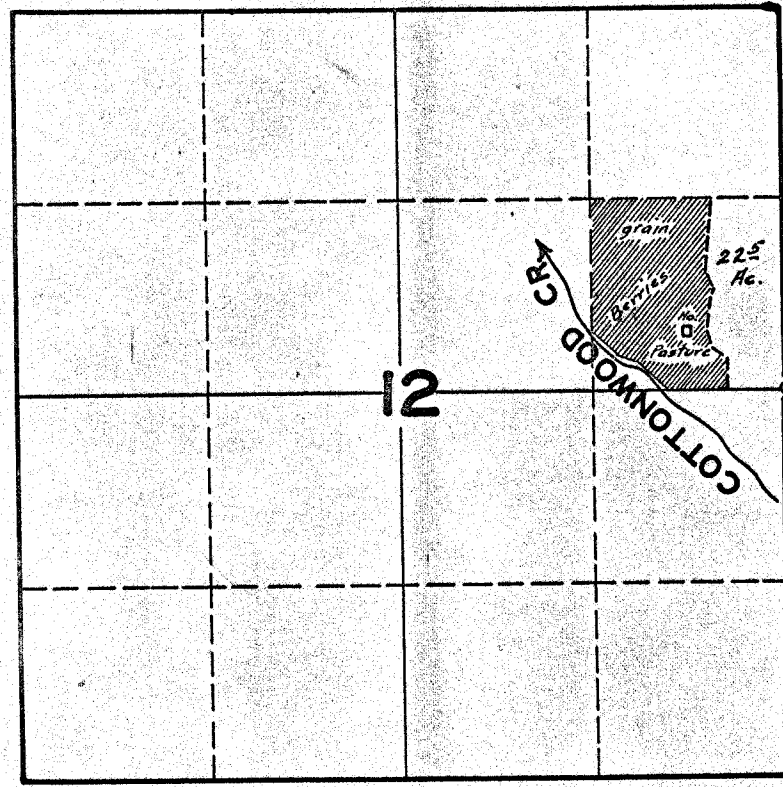

## FINAL PROOF SURVEY UNDER

Application No. 20211... Permit No. 15762

IN NAME OF

EARNEST W. JOHNSON & ELIZABETH S. JOHNSON - HIS WIFE.

Surveyed APR. 24 1946, by *[Signature]*