


T.19S.R.3W.W.M.

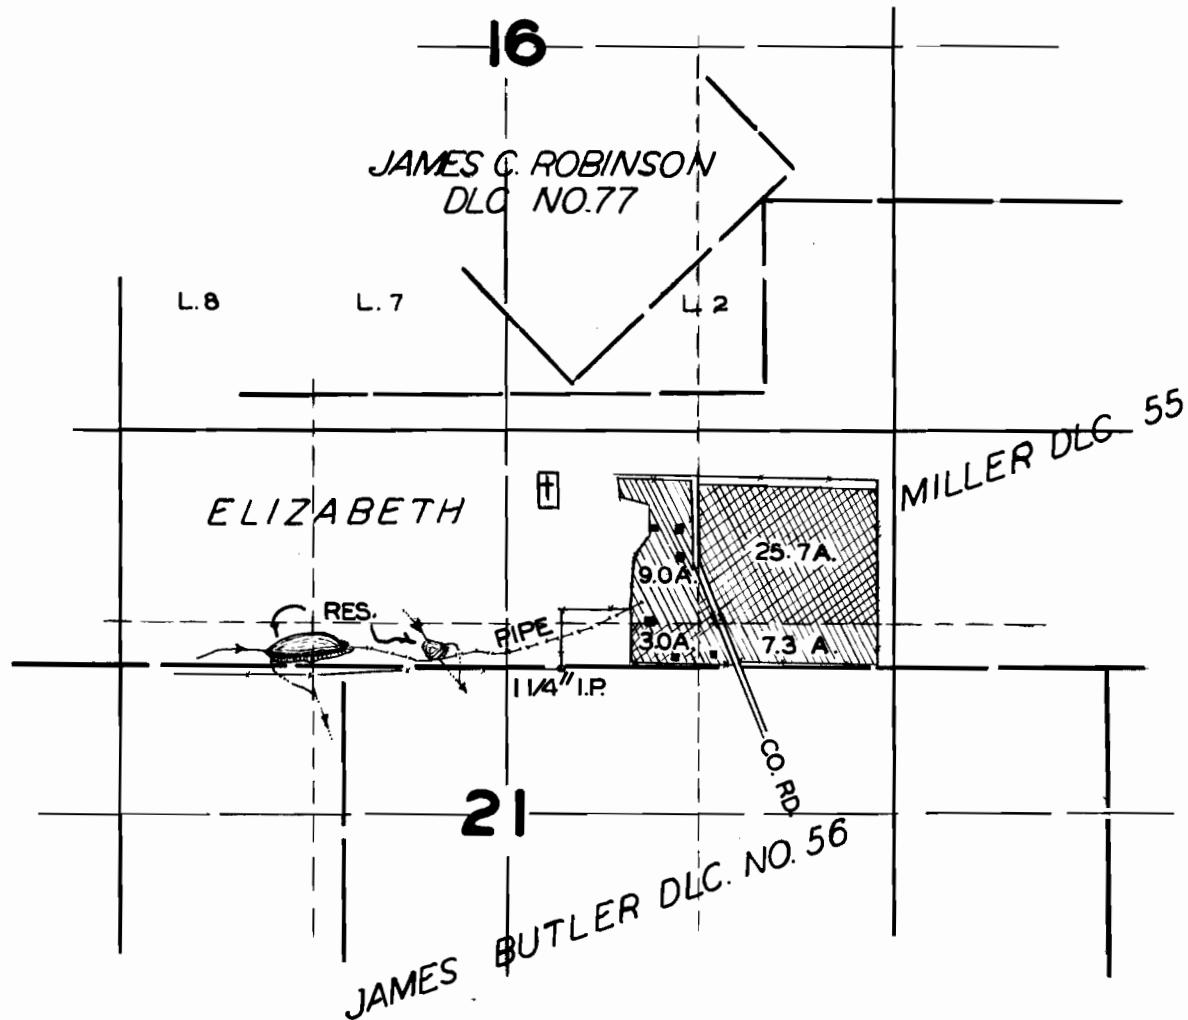

FINAL PROOF SURVEY
UNDER

Application No. 20286... Permit No. 15826...
IN NAME OF

HARRY HOLT, GEORGE R. MILLER AND LEO COLE

Surveyed JUNE 9, 1949, by H.L. COFFMAN...