


T.25S.R.12W.W.M.

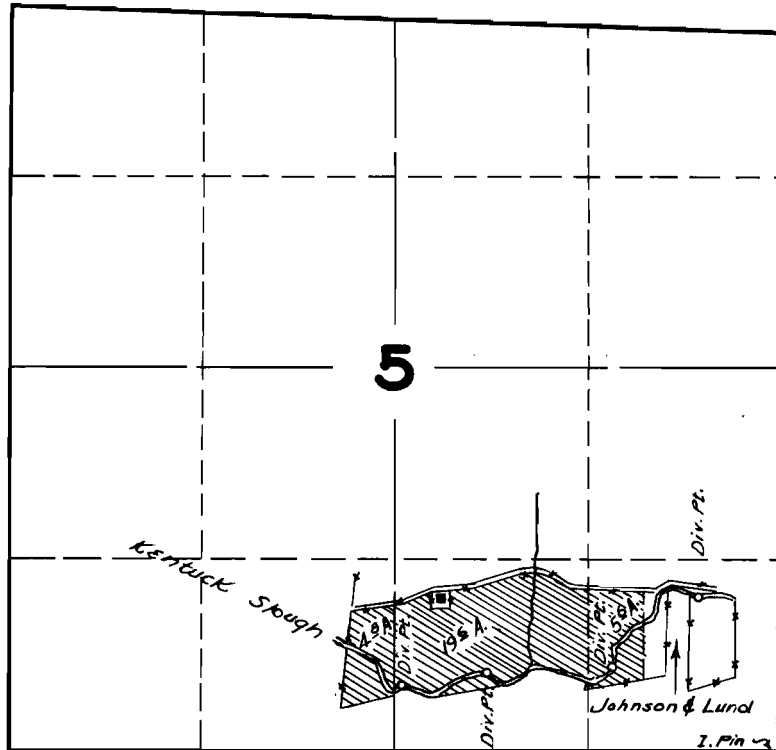

FINAL PROOF SURVEY

UNDER

Application No. 20325.. Permit No. 15856....

IN NAME OF

ARNOLD BERLAGE & MARIE BERLAGE

Surveyed AUG. 23. 1949., by H.L. COFFMAN..