


T.8S.R.3W.W.M.

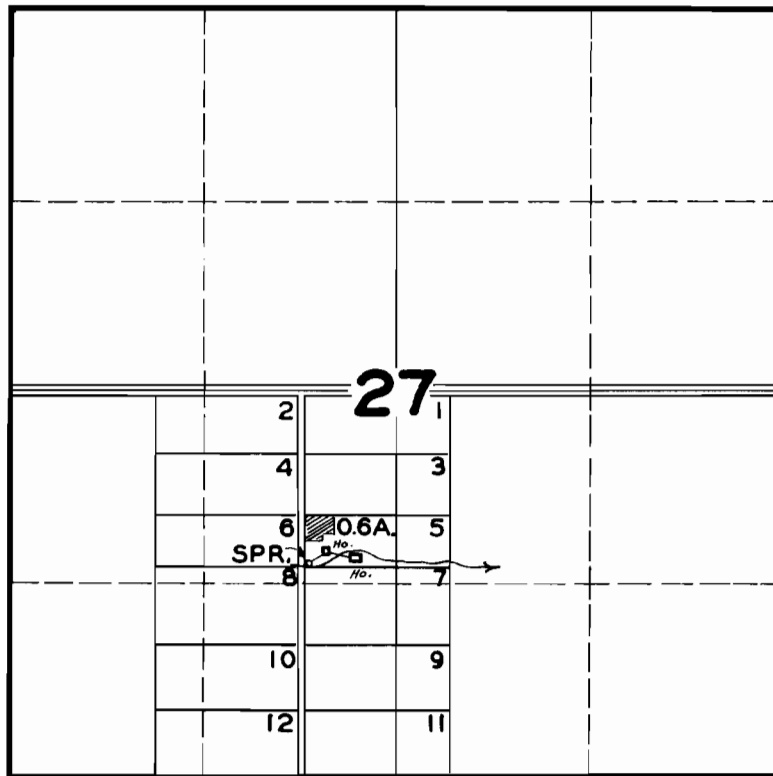

FINAL PROOF SURVEY

UNDER

Application No. **20388** Permit No. **15900**

IN NAME OF

F. H. NORMAN

Surveyed **OCT. 1 1948**, by **JAS. E. BUNNELL**