


T.41S.R.13W.W.M.

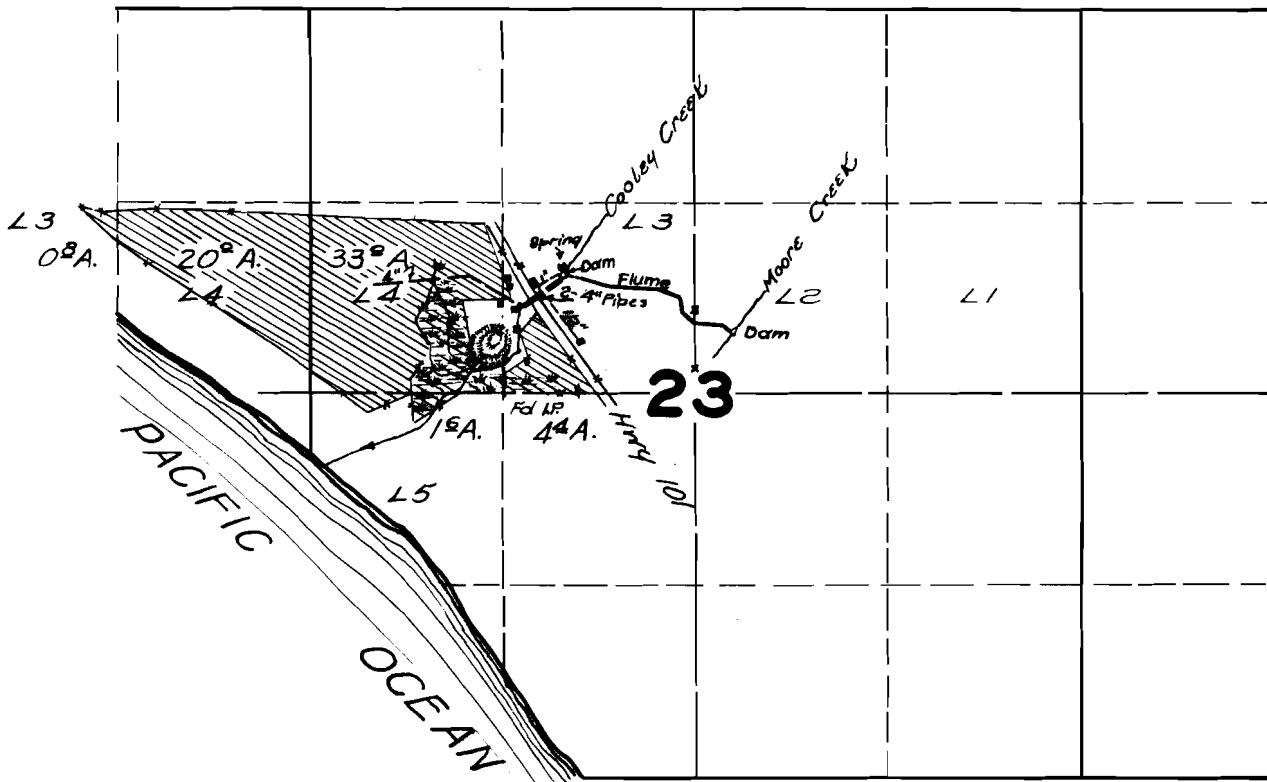

FINAL PROOF SURVEY

UNDER

Application No. 20559 Permit No. 16049

IN NAME OF

WILSON FREEMAN & MAY L. FREEMAN

Surveyed AUG. 8 1949, by H.L. COFFMAN